

RANKIN
F52
6-19-74
E Log # 392

MISSISSIPPI
BOARD OF WATER COMMISSIONERS
 416 North State Street
 Jackson, Mississippi 39201

835
 6/29/74

CODED

WATER WELL DRILLERS LOG

JUN 1974

6-14-1974 date well completed 1974 Singas-Layne Central Div firm name Rankin county well located

LANDOWNER:
 Town of Flowood
 Flowood Miss
 (mailing address)

description of formations encountered	from	to
Brown Clay	0	20
Sand, Gravel & Clay Stks	20	32
Hard Clay	32	120
Sandy Shale	120	212
Sand & Fine Clay Stks	212	402
Hard Clay	402	516
Rock	516	517
Hard Shale	517	537
Rock	537	538
Clay and Sand Stks	538	602
Sand, Clay & Lignite	602	682
Clay & Lignite	682	694
Clay & Fine Sand Stks	694	737
Sand & Clay Stks	737	811
Shale & Sand Stks	811	842
" " "	842	852
Sand	852	899
Sand & Shale Stks	899	928
Hard Shale	928	956

WELL LOCATION:
 sec. 28 T. 6 N. R. 2 E
 (distance) miles (direction) of (nearest town)

WELL PURPOSE: Municipal
 (home, irrigation, municipal, industrial)

WELL COMPLETION DATA:

(1) diameter (inches) 16"

(2) total depth (feet) 906'

(3) static water level (feet) 159 below top of ground

(4) casing Steel 835'
 (material) (depth)

16" If telescope size back.
 (size) 60' 28"

(5) screen 60' 835'
 (length) (depth to top)

8" S.S.W.W.
 (size) (material)

(6) pump 75 500
 (HP) (yield gpm)

Electric
 (type power)

(7) electric log Yes
 (yds or no)

Miss. Geo. Survey
 (organization running log)

(8) how well bottom plugged Valve


CODED

DRILLERS REMARKS:

7

If well telescopes please
sketch and show depths.

GROUND LEVEL

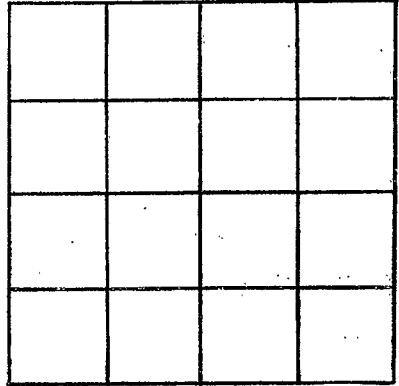

SECTION _____

Please indicate well location X.

ADDITIONAL INFORMATION

If more than one screen,
show locations of each on sketch.