



RANKIN  
F53  
6-27-74  
Elm # 399

MISSISSIPPI  
 BOARD OF WATER COMMISSIONERS  
 416 North State Street  
 Jackson, Mississippi 39201

CODED

WATER WELL DRILLERS LOG

June 27 19 74 JACK Co. Inc. RANKIN  
 date well completed firm name county well located

LANDOWNER: L.A. O'Reilly  
oil INVESTMENTS -  
JACKSON, MISSISSIPPI  
 (mailing address)

description of formations encountered	from	to
yellow CLAY	0	35
DR/Blue CLAY	35	360
SHALING & SAND	360	485
SAND	485	505

WELL LOCATION:  
 sec. 12 T. 6 N. R. 2 E.  
 S W  
 miles of  
 (distance) (direction) (nearest town)

WELL PURPOSE:  
 (home, irrigation, municipal, industrial)

- WELL COMPLETION DATA:
- (1) diameter (inches) 4"
  - (2) total depth (feet) 505
  - (3) static water level (feet) 125 below top of ground.
  - (4) casing 126 / 485  
 (material) (depth)
  - 4" if telescope see back.  
 (size)
  - (5) screen 20 / 485  
 (length) (depth to top)
  - 2" / 55  
 (size) (material)
  - (6) pump 1 / 12  
 (HP) (yield gpm)
  - MPC  
 (type power)
  - (7) electric log YES  
 (yes or no)
  - MCS  
 (organization running log)
  - (8) how well bottom plugged R.W.V.

CODED


RECEIVED  
 SEP 16 1974

DRILLERS REMARKS:

MISS. BD. OF WATER COMMISSIONERS

If well telescopes please sketch and show depths.

GROUND LEVEL

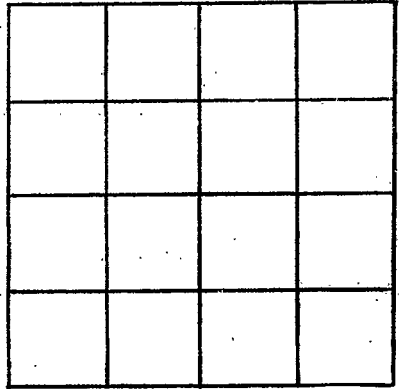

SECTION \_\_\_\_\_

Please indicate well location X.

ADDITIONAL INFORMATION

If more than one screen, show locations of each on sketch.