

RANKIN
F54
10-4-79
Log # 403

MISSISSIPPI
 BOARD OF WATER COMMISSIONERS
 416 North State Street
 Jackson, Mississippi 39201

WATER WELL DRILLERS LOG

CODED

10-4 1974 Forest Drilling Rankin
 date well completed firm name county well located

LANDOWNER: (White System)

Royal white
 Jackson Miss
 (mailing address)

description of formations encountered

from to

Brown clay	0	16
Sand	16	34
Blue Clay	24	235
Shale + silt	225	266
Shale	266	571
Shale + sand	571	631
Fine sand + clay	631	691
Fine sand	691	731
S clay	731	741

WELL LOCATION:

sec 25 T 6 N R 2 E
 W/F - AIRPORT -
 miles of (distance) (direction) (nearest town)

WELL PURPOSE:

(home, irrigation, municipal, industrial)

WELL COMPLETION DATA:

- (1) diameter (inches) 4x2 46-2"
- (2) total depth (feet) 733
- (3) static water level (feet) 130 below top of ground.
- (4) casing Galv. 718 (material) (depth)

(size) if telescope see back.

- (5) screen 15' 718 (length) (depth to top)
 #008 Steel (size) (material)

- (6) pump 3 30 (HP) (yield gpm)
 Elec. 220V (type power)

- (7) electric log yes (yes or no)

Miss Geo. Survey (organization running log)

- (8) how well bottom plugged 2" B.W. Valve

CODED


DRILLERS REMARKS:

MISSISSIPPI
 BOARD OF WATER COMMISSIONERS

M.C. - 2 1974

If well telescopes please sketch and show depths.

GROUND LEVEL

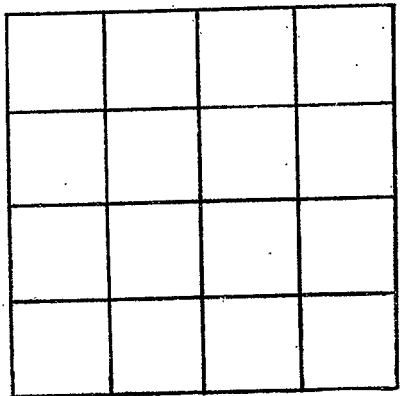

SECTION _____

Please indicate well location X.

ADDITIONAL INFORMATION

If more than one screen,
show locations of each on sketch.