

RANKIN
F55
1-19-76
 Elg #418

MISSISSIPPI
 BOARD OF WATER COMMISSIONERS
 416 North State Street
 Jackson, Mississippi 39201

WATER WELL DRILLERS LOG

date well completed Jan 19, 1976 firm name Roy Urst Water Wells Rankin county well located Rankin
 LOCATION SAMPLE LRV

LANDOWNER: Bob Fugate
PO Box 9733 Jackson
Miss 39206
 (mailing address)

description of formations encountered	from	to
<u>gray clay</u>	<u>0</u>	<u>25</u>
<u>Blue Clay</u>	<u>25</u>	<u>368</u>
<u>Deep shells and sand strata</u>	<u>365</u>	<u>400</u>
<u>clay</u>	<u>400</u>	<u>530</u>
<u>sand</u>	<u>530</u>	<u>565</u>
<u>clay</u>	<u>565</u>	<u>580</u>
<u>sandy strata</u>	<u>580</u>	<u>620</u>

WELL LOCATION:
 sec. 12 T. 6 N. R. 2 E. S. 5 W.
10 miles W Jackson
 (distance) (direction) (nearest town)

WELL PURPOSE: office
 (home, irrigation, municipal, industrial)


- WELL COMPLETION DATA:
- (1) diameter (inches) 4 1/2 in
 - (2) total depth (feet) 568
 - (3) static water level (feet) 140 below top of ground above
 - (4) casing Blk pipe 548
 (material) (depth)
2 if telescope see back.
 (size)
 - (5) screen 20 548
 (length) (depth to top)
2 in St Steel
 (size) (material)
 - (6) pump 1/2 15
 (HP) (yield gpm)
Miss Power
 (type power)
 - (7) electric log yes
 (yes or no)
Miss Geog
 (organization running log)
 - (8) how well bottom plugged wash down

DRILLERS REMARKS:

Put Mar 10-74

If well telescopes please sketch and show depths.

GROUND LEVEL

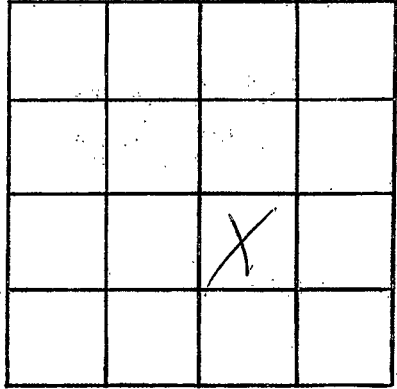

SECTION 12

Please indicate well location X.

ADDITIONAL INFORMATION

If more than one screen,
show locations of each on sketch.