

RANKIN  
 FGI  
 10/19/79

MISSISSIPPI  
 BOARD OF WATER COMMISSIONERS  
 416 North State Street  
 Jackson, Mississippi 39201

CODED

WATER WELL DRILLERS LOG

Oct. 19, 1979 "A.E.M. Bud" CRESSWELL Rankin  
 date well completed firm name county well located

LANDOWNER:  
 Dwayne Sheep  
 JACKSON, MS.  
 (mailing address)

| description of formations encountered | from | to  |
|---------------------------------------|------|-----|
| Clay                                  | 0    | 460 |
| sandy shale                           | 460  | 620 |
| sand                                  | 620  | 680 |

WELL LOCATION:  
 sec. 23 T 6 N R 2 E  
 6 Miles East of Jackson  
 (distance) (direction) (nearest town)

WELL PURPOSE: Home  
 (home, irrigation, municipal, industrial)

- WELL COMPLETION DATA:
- (1) diameter (inches) 4
  - (2) total depth (feet) 680
  - (3) static water level (feet) 180 below top of ground
  - (4) casing PVC 640 (material) (depth)  
 4 (size) if telescope see back.
  - (5) screen 40 640 (length) (depth to top)  
 4 PVC (size) (material)
  - (6) pump 2 30 (HP) (yield gpm)  
 0 (type power)
  - (7) electric log 720 (yes or no)  
 0 (organization running log)

(8) how well bottom plugged  
 Plug

DRILLERS REMARKS:

CODED


DEPT. OF NATURAL RESOURCES  
 BUREAU OF LAND & WATER RESOURCES

NOV - 6 1979

RECEIVED

If well telescopes please sketch and show depths.

GROUND LEVEL

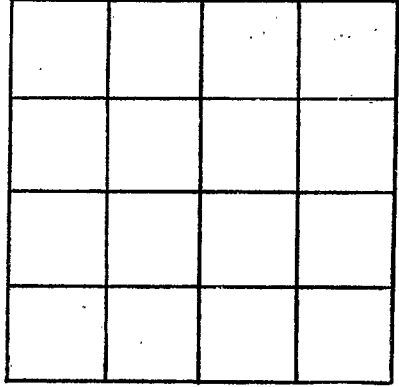

SECTION \_\_\_\_\_

Please indicate well location X.

ADDITIONAL INFORMATION

If more than one screen, show locations of each on sketch.