

RANKIN
 FL2
 11-1-79
 Elog # 498

MISSISSIPPI
 BOARD OF WATER COMMISSIONERS CODED
 416 North State Street
 Jackson, Mississippi 39201

WATER WELL DRILLERS LOG

11/1/79 date well completed
 Jack C. Quinn firm name
 Rankin county well located

LANDOWNER: J. D. White

description of formations encountered

from to

Top soil & clay	0	100
Blue clay	100	420
Sandy spots of sand	420	540
	540	560

(mailing address)

WELL LOCATION:

sec 25 T 6 N R 2 E
 S W
 10 miles W of Jackson

WELL PURPOSE: Home
 (home, irrigation, municipal, industrial)

WELL COMPLETION DATA:

- (1) diameter (inches) 6 in.
- (2) total depth (feet) 58'4 ft.
- (3) static water level (feet) 140 below top of ground.
- (4) casing P.V.C. 540 ft.
 (material) (depth)
 4 in. (size) If telescope see back.
- (5) screen 20 ft. 56 ft.
 (length) (depth to top)
 4 in. P.V.C. (size) (material)
- (6) pump 5 25 gal.
 (HP) (yield gpm)
 Electric (type power)
- (7) electric log yes
 (yes or no)
 M. G. S. (organization running log)

CODED

(8) how well bottom plugged Back
 water valve

DRILLERS REMARKS:


DEPT. OF NATURAL RESOURCES
 BUREAU OF LAND & WATER RESOURCES

FEB - 8 1980

RECEIVED

If well telescopes please sketch and show depths.

GROUND LEVEL

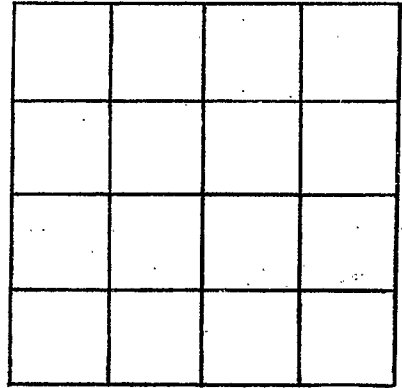

SECTION _____

Please indicate well location X.

ADDITIONAL INFORMATION

If more than one screen,
show locations of each on sketch.