

**CODED**  
2

MISSISSIPPI  
BOARD OF WATER COMMISSIONERS  
416 North State Street  
Jackson, Mississippi 39201

Rankin  
G8  
7-67  
Elec Log  
7-76  
date well completed

WATER WELL DRILLERS LOG

1967 Layne-Central Company Rankin  
firm name county well located

LANDOWNER:  
Langford Water Association  
Langford, Miss.  
(mailing address)

description of formations encountered	from	to
Clay	0	15
Sandy Clay	15	44
Gumbo	44	453
Shale	453	585
Fine Sand	585	618
Sandy Shale	618	683
Fine Sand	683	693
Shale	693	697
Sandy	697	776
Shale	776	778

WELL LOCATION:  
sec. 22 T. 6 N. R. 3 E  
S W  
4-1/2 miles N of Brandon  
(distance) (direction) (nearest town)

WELL PURPOSE: Domestic  
(home, irrigation, municipal, industrial)

WELL COMPLETION DATA:

(1) diameter (inches) 8"

(2) total depth (feet) 778'

(3) static water level (feet) 222' below above top of ground.


(4) casing steel, 732'  
(material) (depth)  
8"  
(size) if telescope see back.

(5) screen 40', 732'  
(length) (depth to top)  
6", Stainless Steel  
(size) (material)

(6) pump 40 200  
(HP) (yield gpm)  
Electric  
(type power)

(7) electric log yes  
(yes or no)  
Miss. GEO. SURVEY  
(organization running log)

(8) how well bottom plugged Plate

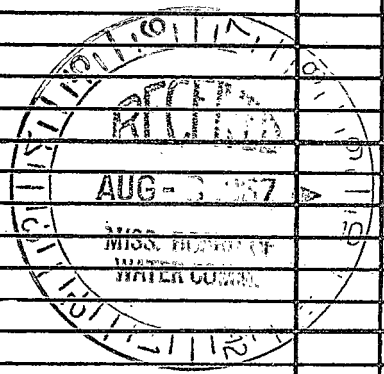

DRILLERS REMARKS:  
Pump Not installed AS OF THIS DATE AND NO capacity test has been run.

⊗

Near SW cor of SE, SE

If well telescopes please sketch and show depths.

GROUND LEVEL


SECTION \_\_\_\_\_

Please indicate well location X.

ADDITIONAL INFORMATION

If more than one screen, show locations of each on sketch.