

RANKIN
G 10
8-10-62

WATER WELL DRILLERS LOG

CODED

Date: 8-10, 1962, Driller: BUD CRESSWELL County RANKIN
(Name)

(1) Owner of Land: W. GRIFFIN
(Name)
BRANDON, MISS.
(Address)

(2) Location: 1/4, 1/4, Sec. 26 R3,
7 miles NORTH, of BRANDON
(distance) (direction) (Nearest Town)

(3) Topography: FLAT
(Hilly) (Flat) (Level)

(4) Purpose of Well: DOMESTIC
(Domestic Irrigation
Municipal, Industrial, Other)

Description & Color of Materials Sand, Clay, Red Clay, Shell, etc.	Thick- ness Feet	Depth Feet
<u>SURFACE MATERIALS</u>	<u>15</u>	<u>15</u>
<u>SAND WHITE</u>	<u>20</u>	<u>35</u>
<u>BLUE CLAY with STR. FINE SAND</u>	<u>245</u>	<u>280</u>
<u>GREENISH SAND AND SEA SHELLS</u>	<u>40</u>	<u>320</u>
<u>GREY SHALE</u>	<u>30</u>	<u>350</u>
<u>GREY SAND COURSE</u>	<u>25</u>	<u>375</u>
<u>GREY SHALE</u>	<u>5</u>	<u>380</u>

Information upon completion of well:

(1) Diameter 2 inches.

(2) Total Depth 380 feet.

(3) Water Level 85 feet below top of ground.

(4) Cased to 360, Size 2"

(5) Screen: Size 2", Length 20


(6) Were any formations sealed against pollution?
_____ yes, _____ no.

CODED

If YES depth of formation _____

Why _____

Drillers Remarks: _____

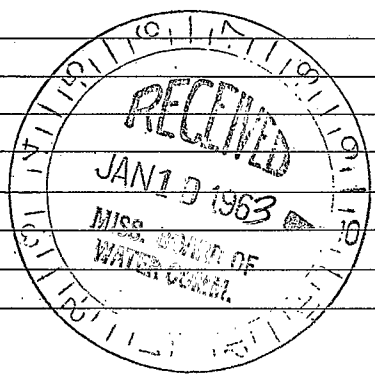

(Use Back Side)

Well No.

