

G11

4-23-65

WATER WELL DRILLERS LOG

**CODED**

Date: 4-23, 1965, Driller: ELLIS E HALL County RANKIN

(Name)

(1) Owner of Land: J.B. PHILLIPS

(Name)

RT 3 BOX 205

BRANDON MISS

(Address)

(2) Location: NW 1/4, NW 1/4, Sec. 30 T6N R3E

6 miles N.W., of BRANDON,  
(distance) (direction) (Nearest Town)

(3) Topography: HILLY

(Hilly) (Flat) (Level)

(4) Purpose of Well: DOMESTIC

(Domestic Irrigation  
Municipal, Industrial, Other)

Description & Color of Materials  
Sand, Clay, Red Clay, Shell, etc.

Thick-  
ness  
Feet

Depth  
Feet

SURFACE SOIL

4

4

YELLOW MARL

18

22

BROWN SHALE + SAND

41

63

YAZOO CLAY

345

408

MOODY BRANCH

40

448

SAND + SHALE

20

468

SAND + LIGNITE

22

490

SAND GOOD

22

512

SAND + LIGNITE

23

535

SAND (GOOD)

92

627

Information upon completion of well:

(1) Diameter 4 X 2 inches.

(2) Total Depth 627 feet.

(3) Water Level \_\_\_\_\_ feet below top of ground.

(4) Cased to 338', Size 4  
279' 2

(5) Screen: Size 2", Length 40

(6) Were any formations sealed against pollution?


\_\_\_\_\_ yes, X no.

If YES depth of formation \_\_\_\_\_

Why \_\_\_\_\_

Drillers Remarks: \_\_\_\_\_

**CODED**

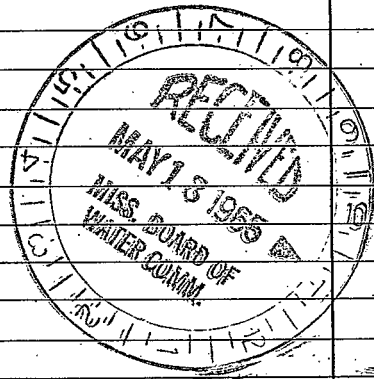

(Use Back Side)

Well No. 127

