

CODED

MISSISSIPPI
BOARD OF WATER COMMISSIONERS
416 North State Street
Jackson, Mississippi 39201

Rankin
G1A
5-67

WATER WELL DRILLERS LOG

date well completed 19 East Drilling Serv. firm name Rankin county well located

LANDOWNER: Don Boyce
Brandon,
Miss.
(mailing address)

description of formations encountered	from	to
<u>brown clay</u>	<u>0</u>	<u>15</u>
<u>Sand & Clay</u>		<u>20</u>
<u>blue clay</u>		<u>204</u>
<u>Clay & silt</u>		<u>215</u>
<u>soft shale</u>		<u>330</u>
<u>shale</u>		<u>371</u>
<u>Clay & sandy shale</u>		<u>392</u>
<u>sandy shale</u>		<u>406</u>
<u>rock</u>		<u>417</u>
<u>shale</u>		<u>452</u>
<u>soft shale & fine sand</u>		<u>473</u>
<u>soft shale & silt</u>		<u>552</u>
<u>fine sand & silt</u>		<u>575</u>
<u>fine sand</u>		<u>656</u>


WELL LOCATION:
28 sec. 6 T. 6 N. R. 3E E. 471 W.
5 miles North of Brandon
(distance) (direction) (nearest town)

WELL PURPOSE:
(home, irrigation, municipal, industrial)

WELL COMPLETION DATA:

- (1) diameter (inches) 2"
- (2) total depth (feet) 646
- (3) static water level (feet) 48 below above top of ground.
- (4) casing Galv., 631,
(material) (depth)
2"
(size) If telescope see back.
- (5) screen 154, 631,
(length) (depth to top)
2", Brass
(size) (material)
- (6) pump 5 HP, 1100 gal per hr.
(HP) (yield gpm)
Electric
(type power)
- (7) electric log no,
(yes or no)
(organization running log)
- (8) how well bottom plugged broken
blue


CODED

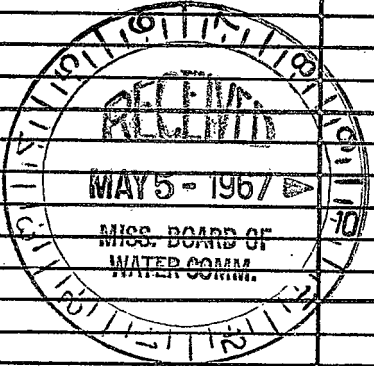

DRILLERS REMARKS:

If well telescopes please sketch and show depths.

GROUND LEVEL

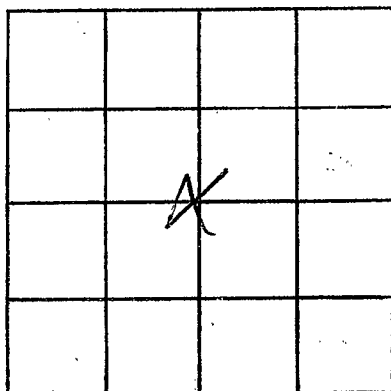

SECTION 28

Please indicate well location X.

ADDITIONAL INFORMATION

If more than one screen,
show locations of each on sketch.