

# CODED

MISSISSIPPI  
BOARD OF WATER COMMISSIONERS  
416 North State Street  
Jackson, Mississippi 39201

## WATER WELL DRILLERS LOG

*Rankin*  
*G15*  
*-68*

date well completed 19 *June* firm name *Frank Drilling Co* county well located *Rankin*

LANDOWNER *Ernest Tomley*  
*258 Wingfield St.*  
*Jackson, Miss*  
(mailing address)

WELL LOCATION:  
sec. *26* T. *6* N. R. *3E*  
S. E.  
*6 1/2* miles *North* of *Brandon*  
(distance) (direction) (nearest town)

WELL PURPOSE: *Home*  
(home, irrigation, municipal, industrial)

### WELL COMPLETION DATA:

- (1) diameter (inches) *2"*
- (2) total depth (feet) *675 ft.*
- (3) static water level (feet) *227* below top of ground.
- (4) casing *Galv 685*  
(material) (depth)  
*2"*  
(size) if telescope see back.
- (5) screen *10 ft 685*  
(length) (depth to top)  
*2"* *Stainless Steel*  
(size) (material)
- (6) pump *5* *1000 GPH*  
(HP) (yield gpm)  
*Electric*  
(type power)
- (7) electric log *No*  
(yes or no)  
  
(organization running log)
- (8) how well bottom plugged *Backwash Valve*

description of formations encountered	from	to
<i>Red Clay</i>	<i>0</i>	<i>20</i>
<i>And. Clay</i>		<i>31</i>
<i>Clay</i>		<i>40</i>
<i>Blue Clay</i>		<i>66</i>
<i>Shale</i>		<i>384</i>
<i>Shaly Str. Rock</i>		<i>410</i>
<i>Shale</i>		<i>430</i>
<i>Sandy Shell + Clay</i>		<i>451</i>
<i>Clay + mdy Sand</i>		<i>471</i>
<i>Shaly + soft Sand</i>		<i>513</i>
<i>Soft Shale</i>		<i>573</i>
<i>Soft Shale + mdy Sand</i>		<i>615</i>
<i>Shale</i>		<i>675</i>
<i>Fine sand + str. clay</i>		<i>675</i>
<i>Fine Sand</i>		<i>675</i>
<i>Fin Sand</i>		<i>675</i>


# CODED

FOR THE RECORD  
MISS. BOARD OF  
WATER COMMISSIONERS

DRILLERS REMARKS:

If well telescopes please sketch and show depths.

GROUND LEVEL

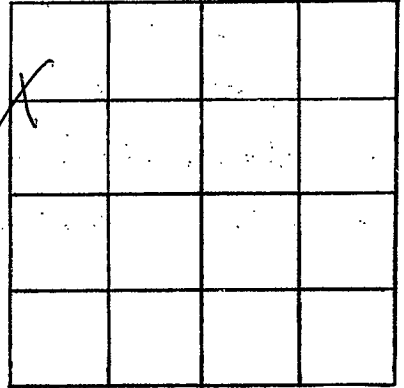

SECTION 26

Please indicate well location X.

ADDITIONAL INFORMATION

If more than one screen, show locations of each on sketch.