

G18

6-9-64

WATER WELL DRILLERS LOG

CODED

Rankin

Date: 6/9/64 19, Driller: Just Dug, Inc. County: Rankin
(Name)

	Description & Color of Materials Sand, Clay, Red Clay, Shell, etc.	Thick- ness Feet	Depth Feet
(1) Owner of Land: <u>Jessie Moore</u> (Name) <u>Rt 3 Brandon, Miss.</u> (Address)	<u>Brown clay</u>		<u>40</u>
(2) Location: <u>1/4</u> , <u>1/4</u> , Sec. <u>15</u> T <u>6</u> R <u>3</u>	<u>Blue clay</u>		<u>382</u>
<u>5</u> miles <u>North</u> , of <u>Brandon</u> (distance) (direction) (Nearest Town)	<u>Shaly & shaly rock</u>		<u>372</u>
(3) Topography: <input checked="" type="checkbox"/> (Hilly) <input type="checkbox"/> (Flat) <input type="checkbox"/> (Level)	<u>Shale</u>		<u>422</u>
(4) Purpose of Well: <u>Home</u> (Domestic Irrigation, Municipal, Industrial, Other)	<u>Sandy shell</u>		<u>452</u>
	<u>Soft shale</u>		<u>500</u>
	<u>7' Sand & clay</u>		<u>512</u>
	<u>Soft shale & shaly sand</u>		<u>532</u>
	<u>Shale</u>		<u>656</u>
	<u>Shale & shaly 7' sand</u>		<u>672</u>
	<u>Fine sand</u>		<u>696</u>

Information upon completion of well:


- (1) Diameter 2 inches.
- (2) Total Depth 695 feet.
- (3) Water Level 168 feet below top of ground.
- (4) Cased to 685, Size 2"
- (5) Screen: Size 2", Length 10ft
- (6) Were any formations sealed against pollution?
no.

If YES depth of formation _____

Why _____

Drillers Remarks: _____

CODED

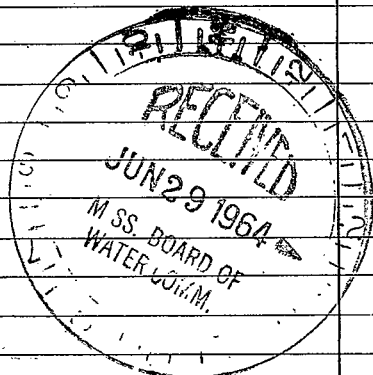

(Use Back Side)

Well No.

