

RANKIN

G 619

619

WATER WELL DRILLERS LOG

4-17-61

**CODED**

Date: 4/13 & 4/17/1961, Driller: Johnnie Beasley

County Rankin

(Name)

(1) Owner of Land: James H. McKay Sr.  
(Name)  
Brandon, Miss.  
Take Hwy. 471 North out of Brandon  
and go about 7 miles, Sec. 33 T. 6 R. 3,  
(2) Location: 7 miles North of Brandon  
(distance) (direction) (Nearest Town)

(3) Topography: x  
(Hilly) (Flat) (Level)

(4) Purpose of Well: Domestic.  
(Domestic Irrigation  
Municipal, Industrial, Other)

Description & Color of Materials Sand, Clay, Red Clay, Shell, etc.	Thick- ness Feet	Depth Feet
Chalk & silt.		0-25
Blue clay.		25-40
Blue clay & lignite.		40-65
Blue clay.		65-370
Blue shale.		370-496
Rock.		496-498
Lime, sand & shell.		498-538
Blue clay & stks. shale.		538-595
Sandy shale.		595-656
Shale.		656-676
Shale & stks. silt.		676-697
Silt sand.		697-717
Sand. (Screen setting)		717-748

Information upon completion of well:

- (1) Diameter 2 inches.
- (2) Total Depth 748' feet.
- (3) Water Level 260' feet below top of ground.
- (4) Cased to 738', Size 2"
- (5) Screen: Size 2", Length 10'
- (6) Were any formations sealed against pollution?  
yes, x no.

Duplicate


Log

**CODED**

If YES depth of formation \_\_\_\_\_

Why \_\_\_\_\_

Drillers Remarks: Good well.

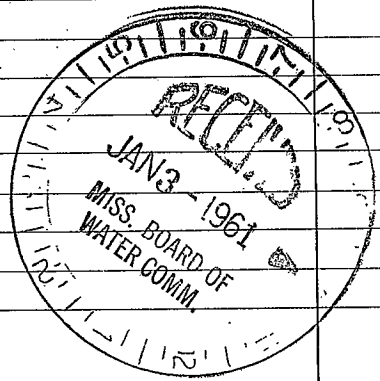

(Use Back Side)

Well No.

