

RANKIN MISSISSIPPI BOARD OF WATER COMMISSIONERS

G20
6-24-61

WATER WELL DRILLERS LOG

CODED

Date: 6/26, 1961, Driller: James McGee Rankin
(Name)

(1) Owner of Land: W. A. Noland
(Name)
Rt. 3, Box 45, Brandon, Miss
(Address)

(2) Location: 1/4, 1/4, Sec. 13 T6 R3,
10 miles North, of Brandon
(distance) (direction) (Nearest Town)

(3) Topography: X
(Hilly) (Flat) (Level)

(4) Purpose of Well: Domestic
(Domestic Irrigation
Municipal, Industrial, Other)

Description & Color of Materials Sand, Clay, Red Clay, Shell, etc.	Thick- ness Feet	Depth Feet
Brown clay.	0	34
Blue clay.	34	192
Shale.	192	252
Shale & stks. rock.	252	262
Shale & stks. rock.	262	272
Shale & stks. rock.	272	325
Shell & rock.	325	345
Soft shale.	345	385
Fine sand & clay.	385	395
Shale & stks. sand.	395	405
Sand & stks. clay.	405	445
Fine sand.	445	463
Sand & stks. clay.	463	482
Fine sand.	482	488
Sand & stks. clay.	488	505
Soft shale.	505	535
Soft shale & sand.	535	565
Shale.	565	610
Fine sand.	610	620
Shale.	620	640
Sand & stks. clay.	640	652
Sand. (Screen set.)	652	675

Information upon completion of well:

(1) Diameter 2 inches.

(2) Total Depth 676 feet.

(3) Water Level 195 feet below top of ground.

(4) Cased to 656', Size 2"

(5) Screen: Size 2", Length 20'

(6) Were any formations sealed against pollution?
yes, X no.


If YES depth of formation _____

Why _____

Drillers Remarks: Good well.

Ruplicate

CODED

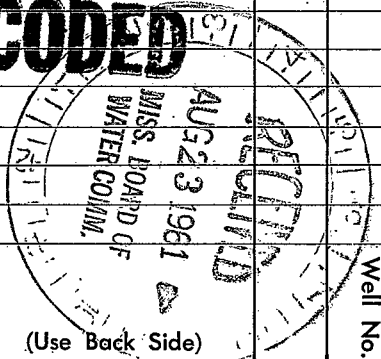

(Use Back Side)

Well No.

