

RANKIN
G 21
10-11-60

MISSISSIPPI BOARD OF WATER COMMISSIONERS

WATER WELL DRILLERS LOG

CODED⁰³

Date: 10/11, 1960, Driller: Johnnie Beasley County: Rankin
(Name)

(1) Owner of Land: J. T. Payne.
(Name)
Rt. #3, Brandon, Miss.
(Address)

(2) Location: 1/4, 1/4, Sec. 4 T5R3
6 miles North, of Brandon
(distance) (direction) (Nearest Town)

(3) Topography: X
(Hilly) (Flat) (Level)

(4) Purpose of Well: Domestic.
(Domestic Irrigation
Municipal, Industrial, Other)

Description & Color of Materials Sand, Clay, Red Clay, Shell, etc.	Thick- ness Feet	Depth Feet
Silt.	0	15
Lime rock.	15	25
Blue clay.	23	90
Silt.	90	95
Blue clay.	95	308
Blue shale.	308	452
Shale.	452	514
Shell, coal & sand.	514	547
Shale.	547	555
Shale & lignite.	555	576
Shale, lignite & silt	576	596
Shale.	596	676
Shale & stks. silt.	676	686
Shale.	686	697
Shale & stks. sand.	697	735
Sand. (Screen set)	735	780

Information upon completion of well:

(1) Diameter 2 inches.

(2) Total Depth 780 feet.

(3) Water Level 200 feet below top of ground.

(4) Cased to 770', Size 2"

(5) Screen: Size 2", Length 10'


(6) Were any formations sealed against pollution?
X yes, X no.

CODED

If YES depth of formation _____

Why _____

Drillers Remarks: Good well.

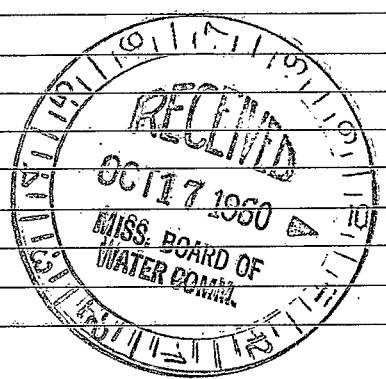

(Use Back Side)

Well No.

1917

Faint, illegible text covering the majority of the page, possibly bleed-through from the reverse side. The text is too light to transcribe accurately.