

RANKIN MISSISSIPPI BOARD OF WATER COMMISSIONERS

G22

6-9-65

WATER WELL DRILLERS LOG

**CODED**

Date: 6-9, 1965, Driller: rust Drilling Co County Rankin  
(Name)

(1) Owner of Land: Bill Ammons  
(Name)  
PO Box 61  
Ridgeland, Miss.  
(Address)

(2) Location: 1/4, 1/4, Sec. 23 T6 R 3  
4 miles North, of Boomer  
(distance) (direction) (Nearest Town)  
May 4 '71

(3) Topography: \_\_\_\_\_  
(Hilly) (Flat) (Level)

(4) Purpose of Well: Home  
(Domestic Irrigation Municipal, Industrial, Other)

Description & Color of Materials Sand, Clay, Red Clay, Shell, etc.	Thick- ness Feet	Depth Feet
Brown Silt + Clay		27
Blue Clay		55
Silt Sand		60
Lignite, lime + shale		723
Blue Clay		410
Hard shale		524
soft shale + silt shell + lime		534
shaly shell + lime		554
shale		617
shaly silt sand		638
Hard shale		704
shaly silt sand		712
shaly		723
Fine sand		755

Information upon completion of well:

(1) Diameter 2" inches.

(2) Total Depth 755 feet.

(3) Water Level 220 feet below top of ground.

(4) Cased to 740, Size 2"

(5) Screen: Size 2", Length 15ft.


(6) Were any formations sealed against pollution?  
 \_\_\_\_\_ yes,  no.

**CODED**

If YES depth of formation \_\_\_\_\_

Why \_\_\_\_\_

Drillers Remarks: \_\_\_\_\_

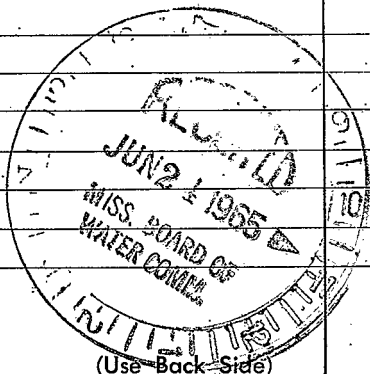

Well No.

(Use Back Side)

