

RANKIN
G23

MISSISSIPPI BOARD OF WATER COMMISSIONERS

CODED

1-24-61

WATER WELL DRILLERS LOG

G

Date: 1/23 & 1/24 1961, Driller: Johnnie Beasley County Rankin
(Name)

(1) Owner of Land: R. L. Swilley
 This well located about 6 miles North ^(Name)
Rt. 3, Brandon, Miss.
 of Brandon on Hwy. ^(Address) 471.

(2) Location: 1/4, 1/4, Sec. 15 T. 6 R. 3
6 miles North, of Brandon
 (distance) (direction) (Nearest Town)

(3) Topography: x
 (Hilly) (Flat) (Level)

(4) Purpose of Well: Domestic
 (Domestic Irrigation
 Municipal, Industrial, Other)

Description & Color of Materials Sand, Clay, Red Clay, Shell, etc.	Thick- ness Feet	Depth Feet
Yellow clay.		0-35
Blue clay.		35-240
Shale & stks. lime.		240-369
Mucky sand, shale & lime.		369-410
Shale & stks. mucky sand.		410-472
Shale.		472-495
Shale & stks. rock.		495-512
Shale.		512-556
Silt sand.		556-597
Fine sand.		597-600
Sand. (Screen setting)		600-670

Information upon completion of well:


- (1) Diameter 2 inches.
- (2) Total Depth 670 feet.
- (3) Water Level 190 feet below top of ground.
- (4) Cased to 655', Size 2"
- (5) Screen: Size 2", Length 15'
- (6) Were any formations sealed against pollution?
yes, x no.

If YES depth of formation _____

Why _____

Drillers Remarks: Good well.

CODED

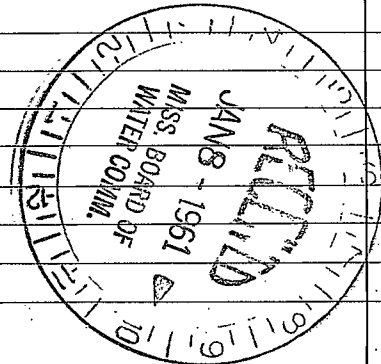

(Use Back Side)

Well No.

