

GW 02862

for pat 104

MISSISSIPPI
BOARD OF WATER COMMISSIONERS
416 North State Street
Jackson, Mississippi 39201

CODED

Raakin
G 24
7-65

WATER WELL DRILLERS LOG

7/22/1965 date well completed
Layne Central Co firm name
Raakin county well located

LANDOWNER: Flood River
Valley Water Supply
District
(mailing address)

description of formations encountered	from to	
top soil	0	1
yellow clay	1	23
blue clay	23	270
sandy shale	270	396
rock	396	398
shale & sand specs	398	469
sand spec shale	469	489
shale sand specs	489	520
shale conung	520	540
sand	540	631
hard clay	631	633

WELL LOCATION:
sec. 7 T. 6 N. R. 3 E
S W
(distance) miles (direction) of (nearest town)

WELL PURPOSE:
(home, irrigation, municipal, industrial)

- WELL COMPLETION DATA:
- (1) diameter (inches) 10 X 6
 - (2) total depth (feet) 633
 - (3) static water level (feet) 120 ^{below} _{above} top of ground.
 - (4) casing Steel
(material) (depth)
(size) if telescope see back.
 - (5) screen 40' 613
(length) (depth to top)
6" st. st.
(size) (material)
 - (6) pump 30 263 @ 60#
(HP) (yield gpm)
(type power)
 - (7) electric log
(yes or no)
(organization running log)
 - (8) how well bottom plugged

DRILLERS REMARKS:

⊗


If well telescopes please sketch and show depths.

GROUND LEVEL

58'
10"

69'
6"
inner case

40'
6"
screen
7/2 opening

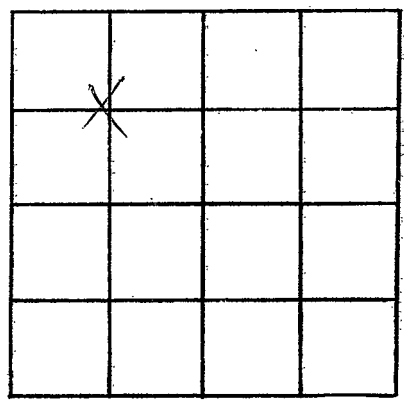

SECTION _____

Please indicate well location X.

ADDITIONAL INFORMATION

Lined area for additional information.

If more than one screen, show locations of each on sketch.