

MISSISSIPPI
BOARD OF WATER COMMISSIONERS
416 North State Street
Jackson, Mississippi 39201

CODED

WATER WELL DRILLERS LOG

RANKIN
G25
11-3-70

11/3 1970 Forest Drilling Rankin
date well completed firm name county well located

LANDOWNER:
Mary Woodruff
Valley, Mississippi
(mailing address)

description of formations encountered	from	to
Clay	0	20
clay + sand	20	32
Blue clay	32	40
Clay + mucky sand	40	62
sand + clay	62	96
Blue clay	96	205
Clay + str. linerock	205	225
Shale	225	496
Rock	496	498
Fine sand + clay	498	520
Clay	520	532
Fine sand + soft shale	532	573
Fine sand + str. clay	573	615
Clay, shale, + fine sand	615	675
Fine sand + str. clay	675	745
Fine sand	745	785
Sand + clay	785	795

WELL LOCATION:
sec. 31 T. 6 N. R. 3 E.
5 miles N/W of Brandon
(distance) (direction) (nearest town)

WELL PURPOSE: home
(home, irrigation, municipal, industrial)

- WELL COMPLETION DATA:**
- (1) diameter (inches) 2"
 - (2) total depth (feet) 781'
 - (3) static water level (feet) 216' below top of ground.
 - (4) casing Steel, 771'
(material) (depth)
2" If telescope see back.
(size)
 - (5) screen 10' (2"), 771'
(length) (depth to top)
2", Stainless Steel
(size) (material)
 - (6) pump 5 1100 GPH
(HP) (yield gpm)
Elect
(type power)
 - (7) electric log no
(yes or no)

(organization running log)
 - (8) how well bottom plugged 2"
Backed ash Valve

CODED

DEC 17 1970


MISS. BD. OF
WATER COMMISSIONERS

FOREST DRILLING SERVICE
237 Highway 35 North
Forest, Mississippi

DRILLERS REMARKS:

If well telescopes please
sketch and show depths.

GROUND LEVEL

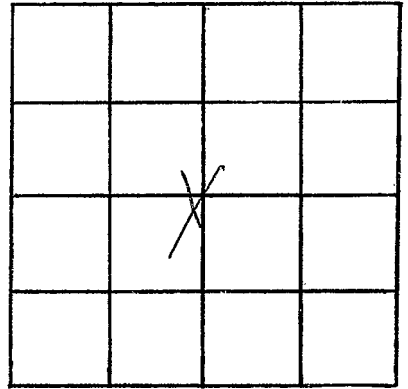

SECTION 31

Please indicate well location X.

ADDITIONAL INFORMATION

If more than one screen,
show locations of each on sketch.