

LOG # 293

**MISSISSIPPI
BOARD OF WATER COMMISSIONERS
416 North State Street
Jackson, Mississippi 39201**

FEB 25 1972

WATER WELL DRILLERS LOG

Codal


RANKIN
G26
3-23-71

June 14, 1972 date well completed Robert E. Ratliff/Co. firm name Rankin county well located

LANDOWNER:	description of formations encountered	from	to
<u>Pearl River</u>	<u>Red Sandy Clay</u>	<u>0</u>	<u>100</u>
<u>Valley Water Supply</u>	<u>Clay</u>	<u>100</u>	<u>340</u>
<u>Jackson, Miss.</u>	<u>Sand</u>	<u>340</u>	<u>390</u>
(mailing address)	<u>Clay</u>	<u>390</u>	<u>480</u>
WELL LOCATION:	<u>Sandy Clay</u>	<u>480</u>	<u>510</u>
sec. <u>6</u> T. <u>6</u> (N) R. <u>3</u> (E)	<u>Sandy Clay</u>	<u>510</u>	<u>610</u>
<u>8</u> miles <u>North East</u> of <u>Jackson</u>	<u>Sand</u>	<u>610</u>	<u>690</u>
(distance) (direction) (nearest town)			
WELL PURPOSE: <u>Industrial</u>			
(home, irrigation, municipal, industrial)			
WELL COMPLETION DATA:			
(1) diameter (inches) <u>10" x 6"</u>			
(2) total depth (feet) <u>690'</u>			
(3) static water level (feet) <u>134'</u> below top of ground.			
(4) COATED casing <u>PLASITE</u> , <u>616'</u>			
(material) (depth)			
<u>10" x 6"</u> if telescope see back.			
(size)			
(5) screen <u>40'</u> , <u>650'</u>			
(length) (depth to top)			
<u>6"</u> , <u>S.S.</u>			
(size) (material)			
(6) pump <u>30</u> , <u>250</u>			
(HP) (yield gpm)			
<u>Electric</u>			
(type power)			
(7) electric log <u>Yes</u>			
(yes or no)			
<u>Miss. Geol. Survey</u>			
(organization running log)			
(8) how well bottom plugged <u>Welded</u>			
DRILLERS REMARKS:			

If well telescopes please sketch and show depths.

← 10" →

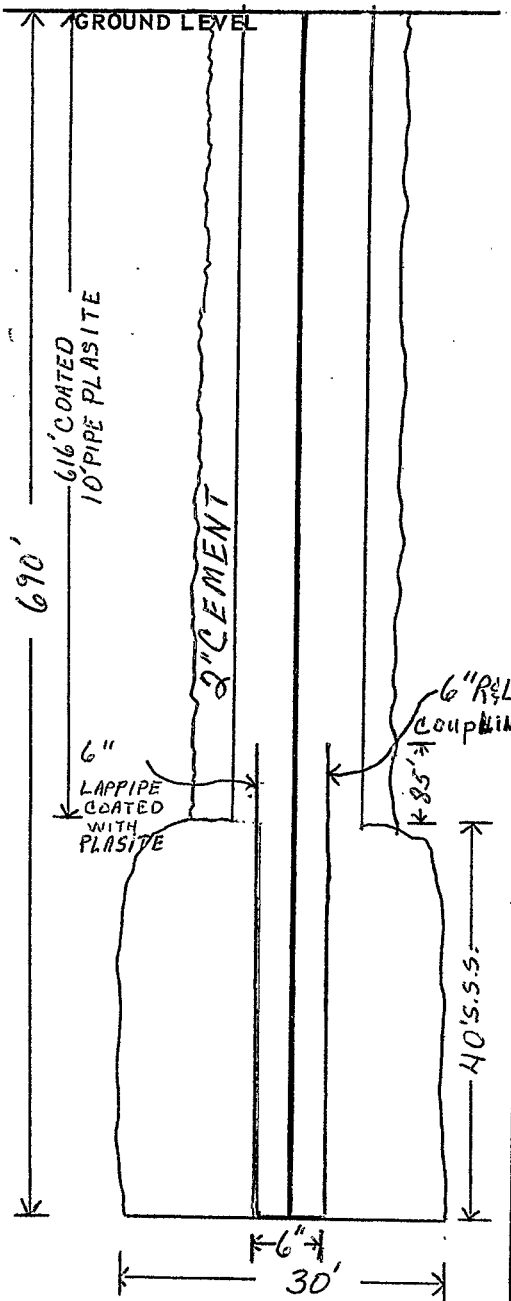

x 6			

SECTION 6

Please indicate well location X.

ADDITIONAL INFORMATION

If more than one screen, show locations of each on sketch.