

RANKIN

MISSISSIPPI BOARD OF WATER COMMISSIONERS

G29

5-25-61

WATER WELL DRILLERS LOG

CODED

Date: 5/25, 1961, Driller: Johnnie Beasley, County Rankin

(Name)

(1) Owner of Land: M. F. Payne
(Name)
 This well located about 8 miles North
Rt. 3, Box 40, Brandon, Miss.
(Address)
 of Brandon on Hwy. 471.
 (2) Location: 1/4, 1/4, Sec. 1 R 63
8 miles North, of Brandon
(distance) (direction) (Nearest Town)
 (3) Topography: X
(Hilly) (Flat) (Level)
 (4) Purpose of Well: Domestic.
(Domestic Irrigation, Municipal, Industrial, Other)


Description & Color of Materials Sand, Clay, Red Clay, Shell, etc.	Thick- ness Feet	Depth Feet
Yellow clay.		0-28
Blue clay.		28-307
Blue shale.		307-327
Shale, sand & coal.		327-347
Rock, silt & shale.		347-368
Shale & silt.		368-580
Fine sand.		580-586
Sand. (Screen sitting)		586-645

Information upon completion of well:

(1) Diameter 2 inches.
 (2) Total Depth 645 feet.
 (3) Water Level 155 feet below top of ground.
 (4) Cased to 630', Size 2"
 (5) Screen: Size 2", Length 15'
 (6) Were any formations sealed against pollution?
no.

If YES depth of formation _____
 Why _____
 Drillers Remarks: Good well.

CODED

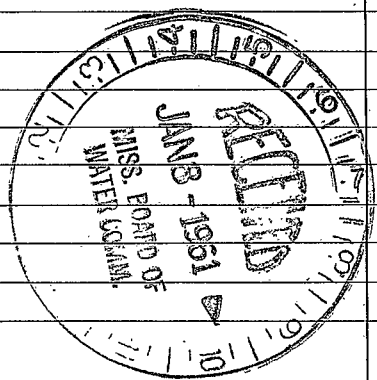

(Use Back Side)

Well No.

