

RANKIN

MISSISSIPPI BOARD OF WATER COMMISSIONERS

G 30

WATER WELL DRILLERS LOG

CODED

10-8-63

Date: 10/8, 19, Driller: Forest Dely Sw County Scott

(1) Owner of Land: John Purney
 (Name)
North
Old Hwy 80 between Brandon
 (Address) +
 (2) Location: 31 63
 1/4, 1/4, Sec. T R
 (distance) (direction) (Nearest Town)
 (3) Topography: _____
 (Hilly) (Flat) (Level)
 (4) Purpose of Well: Home
 (Domestic Irrigation
 Municipal, Industrial, Other)


| Description & Color of Materials Sand, Clay, Red Clay, Shell, etc. | Thick- ness Feet | Depth Feet |
|---|------------------------|---------------|
| Red Clay | 0 | 35 |
| Blue Clay | | 20.5 |
| Shale | | 410 |
| Shale + Shale | | 516 |
| Shale + Sand | | 536 |
| Shale | | 564 |
| Fine Sand | | 575 |
| Shale + Shale | | 576 |
| Shale | | 701 |
| Fine Sand | | 711 |
| Sand + Shale | | 740 |
| Fine Sand | | 743 |
| Shale + Shale | | 759 |
| Fine Sand | | 764 |
| Sand + Shale | | 790 |

Information upon completion of well:

(1) Diameter 2 inches.
 (2) Total Depth 787 feet.
 (3) Water Level 190 feet below top of ground.
 (4) Cased to 777, Size _____
 (5) Screen: Size 2", Length 10ft.
 (6) Were any formations sealed against pollution?
 _____ yes, X no.

If YES depth of formation _____
 Why _____
 Drillers Remarks: _____

CODED

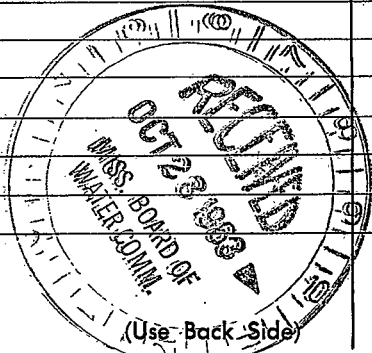

Well No.

