

6-24-63

WATER WELL DRILLERS LOG

CODED

Date: 6-24, 1963, Driller: Paul Dely County Rankin
(Name)

(1) Owner of Land: C. E. Burdett
(Name)
Brandon, Miss
(Address)

(2) Location: 1/4, 1/4, Sec 22 T6 R3,
_____ miles _____ of _____
(distance) (direction) (Nearest Town)

(3) Topography: _____
(Hilly) (Flat) (Level)

(4) Purpose of Well: Home
(Domestic Irrigation
Municipal, Industrial, Other)

Description & Color of Materials Sand, Clay, Red Clay, Shell, etc.	Thick- ness Feet	Depth Feet
Red Clay	0	12
Red sand + clay		30
Blue clay		159
lime rock		162
Clay		302
Shale		383
Shale + shls rock		404
Shale		443
Shale + rock		453
Shale		553
Fine sand		570
Shale + shls sand		610
Fine sand + shls clay		620
Shale + shls fine sand		640
Fine sand + shale		650
Fine sand		660
Coaked sand		676
Shale + shls sand		703
Fine sand		726

Information upon completion of well:

(1) Diameter 2" inches.

(2) Total Depth 726 feet.

(3) Water Level 200 feet below top of ground.

(4) Cased to 711, Size 2"


(5) Screen: Size 2", Length 15ft

(6) Were any formations sealed against pollution?
_____ yes, X no.

If YES depth of formation _____

Why _____

Drillers Remarks: _____

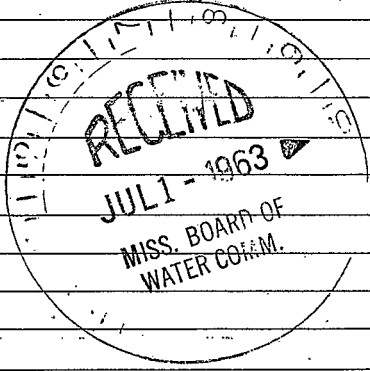

CODED

(Use Back Side)

Well No.

