

Well was drilled in 1983 but pump wasn't put on it until 1986 at which time this log was sent

MISSISSIPPI  
BOARD OF WATER COMMISSIONERS  
416 North State Street  
Jackson, Mississippi 39201

MS-6W-00413  
610090-01  
in CODED

WATER WELL DRILLERS LOG

Layne-Central

Rankin

RANKIN  
G-47  
Z-86  
2-83

date well completed 19 \_\_\_\_\_ firm name \_\_\_\_\_ county well located \_\_\_\_\_

LANDOWNER: Jay Crossville  
Water Assoc. 108 Office  
Park Dr. Brandon, MS 39042  
(mailing address)

WELL LOCATION:  
sec. 30 T. 6 N. R. 3 E.  
S. W.  
4 miles NW of Brandon  
(distance) (direction) (nearest town)

WELL PURPOSE:  
(home, irrigation, municipal, industrial)

WELL COMPLETION DATA:

(1) diameter (inches) 12"

(2) total depth (feet) 1176'

(3) static water level (feet) 223' below top of ground.

(4) casing Steel, 1102'  
(material) (depth)

12" if telescope see back.  
(size) 63' 8" of 8"

(5) screen 20' 10", 1102'  
(length) (depth to top)

8", S. Steel  
(size) (material)

(6) pump 100 500  
(HP) (yield gpm)

electric  
(type power)

(7) electric log yes  
(yes for no)

Layne-Central Co.  
(organization running log)

(8) how well bottom plugged \_\_\_\_\_

description of formations encountered	from	to
Yellow Clay	0'	40
Blue Clay	40	450
Shale	450	490
Shale	490	521
Sandy Shale	521	552
Shale with Sand Streaks	552	695
Sand with Shale Streaks	695	740
Shale with Sand Streaks	740	750
Shale	750	785
Shale	785	881
Rocks	881	884
Clay	884	914
Rocks	914	915
Clay	915	960
Sandy Shale	960	1067
Fine Sand	1067	1098
Sand	1098	1200
Sand & Clay Streaks	1200	1230
Shale	1230	1250


RECEIVED  
MAR 7 - 1986

DRILLERS REMARKS:  
MSHW-00413

Department of Natural Resources  
Bureau of Land & Water Resources

If well telescopes please sketch and show depths.

GROUND LEVEL

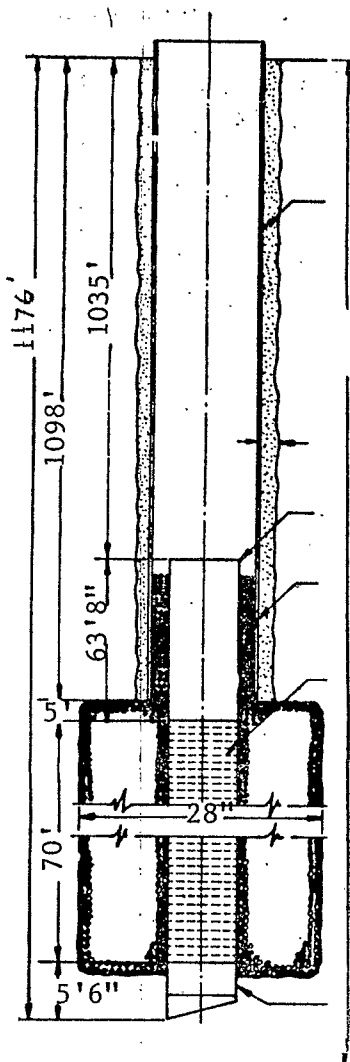


SECTION \_\_\_\_\_

Please indicate well location X.

ADDITIONAL INFORMATION

If more than one screen, show locations of each on sketch.