

MISSISSIPPI DEPARTMENT OF NATURAL RESOURCES
Bureau of Land and Water Resources
 Southport Mall
 P.O. Box 10631
 Jackson, Mississippi 39209
WATER WELL DRILLERS LOG

Coded

RANKIN
G 49
4-11-86

April 11 19 86 E. M. Bud CRESSWELL RANKIN
 date well completed firm name county well located


LANDOWNER:
MS. MATERIALS Co.
Brandon, MS.
 (mailing address)

description of formations encountered	from	to
	<u>Sand</u>	<u>0</u>
<u>blue clay</u>	<u>30</u>	<u>260</u>
<u>sand</u>	<u>260</u>	<u>390</u>
<u>shale</u>	<u>390</u>	<u>430</u>
<u>sand</u>	<u>430</u>	<u>615</u>
<u>shale</u>	<u>615</u>	<u>890</u>
<u>sand</u>	<u>890</u>	<u>970</u>
<u>shale</u>	<u>970</u>	<u>970</u>

WELL LOCATION:
 sec. 11 T. 6 N. R. 3 E
5 miles North of Brandon
 (distance) (direction) (nearest town)

WELL PURPOSE: Industrial
 (home, irrigation, municipal, industrial)

- WELL COMPLETION DATA:**
- diameter (inches) 6 x 4
 - total depth (feet) 990
 - static water level (feet) 165 below top of ground.
 - casing Steel, 910
 (material) (depth)
6 if telescope see back.
 (size)
 - screen 60 910
 (length) (depth to top)
4 Stainless
 (size) (material)
 - pump 20 200
 (HP) (yield gpm)
 (type power)
 - electric log yes
 (yes or no)
State
 (organization running log)
 - how well bottom plugged Back Wash

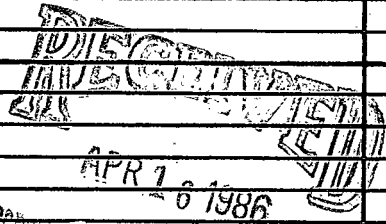


DRILLERS REMARKS:
Permit applied for

Department of Natural Resources
 Bureau of Land and Water Resources
 Jackson, Mississippi 39209

If well telescopes please
sketch and show depths.

GROUND LEVEL

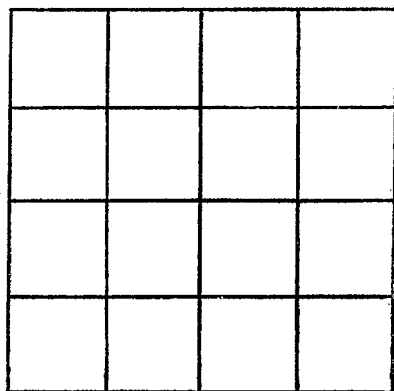

SECTION _____

Please indicate well location X.

ADDITIONAL INFORMATION

If more than one screen,
show locations of each on sketch.