

MISSISSIPPI DEPARTMENT OF NATURAL RESOURCES

Bureau of Land and Water Resources

Southport Mall

P.O. Box 10631

Jackson, Mississippi 39209

WATER WELL DRILLERS LOG

RECORDED

RANKIN  
G 50

July 1 1987  
date well completed

87 E.M. Bud Cresswell  
firm name

RANKIN  
county well located

LANDOWNER:  
Gil Crumbley  
JACKSON, MS.  
(mailing address)

description of formations encountered	from	to
Yellow Clay	0	30
Blue Clay	30	400
Muddy Branch	400	440
Sandy Shale - rocks	400	534
Shale	534	620
Sand - Shale - blue	620	740
Shale	740	1040
Sandy Shale	1040	1100
Sand	1100	1160

WELL LOCATION:  
sec 18 T 6 N R 3 E  
6 miles North of Brandon  
(distance) (direction) (nearest town)

WELL PURPOSE: Home  
(home, irrigation, municipal, industrial)

- WELL COMPLETION DATA:
- (1) diameter (inches) 4
  - (2) total depth (feet) 1160
  - (3) static water level (feet) 240 below top of ground.
  - (4) casing Steel / 1120  
(material) (depth)  
4 if telescope see back.  
(size)
  - (5) screen 40 / 1120  
(length) (depth to top)  
2 / STAINLESS  
(size) (material)
  - (6) pump 2 / 20  
(HP) (yield gpm)  
(type power)
  - (7) electric log no  
(yes or no)  
(organization running log)
  - (8) new well bottom plugged back wash


DRILLERS REMARKS:

RECEIVED  
JUL 8 1987

Department of Natural Resources  
Bureau of Land & Water Resources

If well telescopes please  
sketch and show depths.

GROUND LEVEL

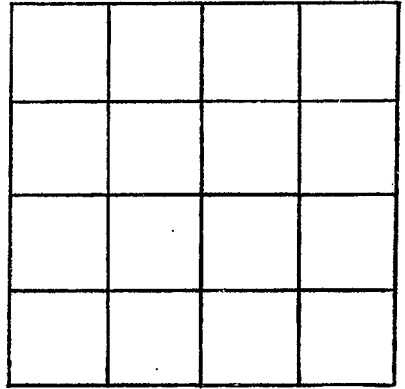

SECTION \_\_\_\_\_

Please indicate well location X.

ADDITIONAL INFORMATION

If more than one screen,  
show locations of each on sketch.