

Rankin  
G 2000  
6/26

MISSISSIPPI  
 BOARD OF WATER COMMISSIONERS  
 416 North State Street  
 Jackson, Mississippi 39201

137

WATER WELL DRILLERS LOG

June 1976 Thomas & Son Rankin  
 date well completed firm name county well located

LANDOWNER: Paul Freeny  
Brandon, Miss.  
Palahatchie Bay Bait Shop  
 (mailing address)

description of formations encountered	from	to
<u>fine clay</u>	<u>0</u>	<u>20</u>
<u>course sand</u>	<u>20</u>	<u>31</u>
<u>Blue &amp; Grey chalk</u>	<u>31</u>	<u>268</u>
<u>Shell &amp; Grey -</u>	<u>268</u>	<u>294</u>
<u>Green Sand</u>		

WELL LOCATION:  
 sec. 2 T. 6 N. R. 3 E  
                   S                  W  
7 miles N of Brandon  
 (distance) (direction) (nearest town)

WELL PURPOSE: Bait Shop  
 (home, irrigation, municipal, industrial)

WELL COMPLETION DATA:

(1) diameter (inches) 2

(2) total depth (feet) 294

(3) static water level (feet) 80 <sup>(below)</sup> <sub>above</sub> top of ground

(4) casing PVC 274  
 (material) (depth)  
2  
 (size) If telescope see back.

(5) screen 20 274  
 (length) (depth to top)  
2" 9 slot PVC  
 (size) (material)

(6) pump 3 Air 1.5  
 (HP) (yield gpm)  
elec.  
 (type power)

(7) electric log NO  
 (yes or no)

(organization running log)


(8) how well bottom plugged Point

DRILLERS REMARKS:

**RECEIVED**  
**AUG 16 1976**  
 MISSISSIPPI BOARD OF WATER COMMISSIONERS

If well telescopes please sketch and show depths.

GROUND LEVEL

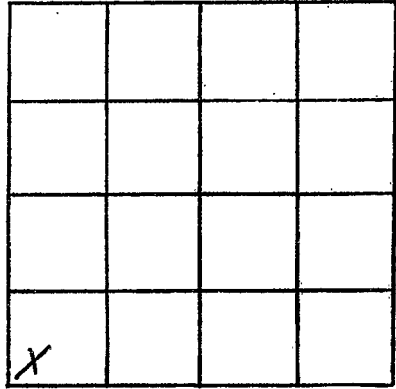

SECTION 2

Please indicate well location X.

ADDITIONAL INFORMATION

If more than one screen, show locations of each on sketch.