

MISSISSIPPI DEPARTMENT OF NATURAL RESOURCES

Bureau of Land and Water Resources

Southport Mall

P.O. Box 10631

Jackson, Mississippi 39209

WATER WELL DRILLERS LOG

Rankin
G
2001

May-18 1982 E.M. "Bud" Cresswell Rankin
 the well completed firm name county well located

LANDOWNER:	description of formations encountered	from	to
St. Peters by the Lake Brandon, Ms. (mailing address)			
WELL LOCATION: sec. <u>7</u> T. <u>6</u> N. R. <u>3</u> E <u>5</u> miles <u>NE</u> of <u>Jackson</u> (distance) (direction) (nearest town)			
WELL PURPOSE: <u>Cherish</u> (home, irrigation, municipal, industrial)			
WELL COMPLETION DATA:			
(1) diameter (inches) <u>4</u>			
(2) total depth (feet) <u>640</u>			
(3) static water level (feet) <u>120</u> below top of ground. above			
(4) casing <u>PVC</u> <u>610</u> (material) (depth) <u>4</u> if telescope see back. (size)			
(5) screen <u>30</u> <u>610</u> (length) (depth to top) <u>2</u> <u>PVC</u> (size) (material)			
(6) pump <u>1</u> <u>15</u> (HP) (yield gpm) (type power)			
(7) electric log <u>no</u> (yes or no) (organization running log)			
(8) how well bottom plugged <u>Sand - Shale</u>			

DEPT. OF NATURAL RESOURCES
BUREAU OF LAND & WATER RESOURCES


JUN - 8 1982

RECEIVED

DRILLERS REMARKS:

If well telescopes please sketch and show depths.

GROUND LEVEL

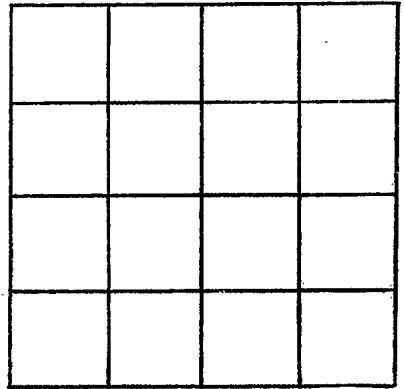

SECTION _____

Please indicate well location X.

ADDITIONAL INFORMATION

If more than one screen,
show locations of each on sketch.