

Rankin
H-8
11-66

MISSISSIPPI BOARD OF WATER COMMISSIONERS

WATER WELL DRILLERS LOG

Date: 11-2-66, 10-31, 19 66, Driller: Trust Drilling Co., County: Rankin.

COPIED
 MGS
 COPIED

(1) Owner of Land: Evergreen Water
 (Name) Assn.
Rankin County, Miss.
 (Address)

(2) Location: NE 1/4, SW 1/4, Sec. 31 T6 N R4 E
3 miles SW of Brandon
 (distance) (direction) (Nearest Town)

(3) Topography: (Hilly) (Flat) (Level)

(4) Purpose of Well: Test well
 (Domestic Irrigation, Municipal, Industrial, Other)

Description & Color of Materials Sand, Clay, Red Clay, Shell, etc.	Thick- ness Feet	Depth Feet
Brown Clay	20	20
Clay + shells & mica band	24	44
Clay	58	102
Clay + shells fine band	20	122
Clay	66	188
Rock	7	190
Shaly Clay	139	329
Shale	42	371
Hard Shale	102	473
Sandy Shell + Rock	20	493
Sandy Shell + clay	20	513
Clay + Silt	32	555
Shale + Silt	31	586
Shale + shells Rock	10	596
Shale + Silt band	21	617
Soft Shale	19	636
Rock	1	637
Shale	40	677
Silt band	20	697
Fine Sand	100	797
Shale	85	857

Information upon completion of well:

(1) Diameter 8 inches.

(2) Total Depth 857 feet.

(3) Water Level 224 feet below top of ground.

(4) Cased to 720, Size 8"


(5) Screen: Size 008 6", Length 40'

(6) Were any formations sealed against pollution?
 _____ yes, no.

If YES depth of formation _____

Why _____

Drillers Remarks: Electric Log
Run - Miss. Geo Survey
11-2-66

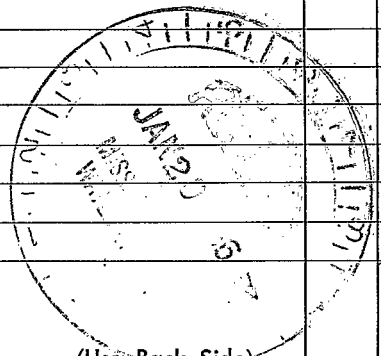

(Use Back Side)

Well No.

