

**RANKIN**  
**H 11**  
**5-1-61**

**WATER WELL DRILLERS LOG**

**CODED**

Date: 5/1, 1961, Driller: Johnnie Beasley County: Rankin  
 (Name)

(1) Owner of Land: Garth Interprises  
 (Name)  
Pelahatchie, Miss  
 Turn North off <sup>(Address)</sup> Hwy. 80 at Rankin  
 and go about 1/2 miles, Sec. 8 T. 6 R. 4  
 (2) Location:  
8 miles North East of Brandon.  
 (distance) (direction) (Nearest Town)

(3) Topography: x  
 (Hilly) (Flat) (Level)

(4) Purpose of Well: Dairy farm  
 (Domestic Irrigation  
 Municipal, Industrial, Other)

Information upon completion of well:

(1) Diameter 2 inches.  
 (2) Total Depth 702 feet.  
 (3) Water Level 165 feet below top of ground.  
 (4) Cased to 687', Size 2"  
 (5) Screen: Size 2", Length 15'  
 (6) Were any formations sealed against pollution?  
yes, x no.


If YES depth of formation \_\_\_\_\_

Why \_\_\_\_\_

Drillers Remarks: Good well.

Description & Color of Materials Sand, Clay, Red Clay, Shell, etc.	Thick- ness Feet	Depth Feet
Clay.	0-	25
Blue clay.	25-	266
Blue clay & stks. rock.	266-	286
Blue clay & shale.	286-	349
Sand, shell & lime.	349-	360
Sand, shell & stks. shale.	360-	369
Shale.	369-	410
Shale & stks. silt.	410-	491
Fine sand.	491-	506
Shale & stks. sand.	506-	537
Fine sand.	537-	574
Shale & stks. sand.	574-	600
Fine sand & stks. shale.	600-	612
Fine sand.	612-	617
Sand & stks. shale.	617-	627
Fine sand.	627-	680
Sand. (Screen Setting)	680-	702
Shale.	702-	705

**CODED**

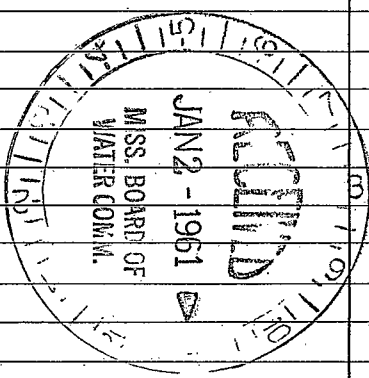

(Use Back Side)

Well No.

