

RANKIN  
H 14

WATER WELL DRILLERS LOG

CODED

6-21-62  
Date: June 21, 1962

Driller: Roy Wilkerson County Rankin  
(Name)

(1) Owner of Land: Willie Beard  
(Name)  
Brandon, Miss.  
(Address)  
2964

(2) Location: 1/4, 1/4, Sec. — T. R,  
10 miles N-E, of Rankin,  
(distance) (direction) (Nearest Town)

(3) Topography: Hilly  
(Hilly) (Flat) (Level)

(4) Purpose of Well: Domestic  
(Domestic Irrigation  
Municipal, Industrial, Other)

Description & Color of Materials Sand, Clay, Red Clay, Shell, etc.	Thick- ness Feet	Depth Feet
<u>Top Soil</u>	<u>1</u>	
<u>Red Clay</u>	<u>40</u>	
<u>Blue Mud &amp; Shell</u>	<u>500</u>	
<u>Rocky</u>	<u>64</u>	
<u>Water Sand</u>	<u>40</u>	

Information upon completion of well:

(1) Diameter 2 inches.

(2) Total Depth 645 feet.

(3) Water Level 145 feet below top of ground.

(4) Cased to 645, Size 2"

(5) Screen: Size 2", Length 6


(6) Were any formations sealed against pollution?  
\_\_\_\_\_ yes, \_\_\_\_\_ no.

CODED

If YES depth of formation \_\_\_\_\_

Why \_\_\_\_\_

Drillers Remarks: \_\_\_\_\_

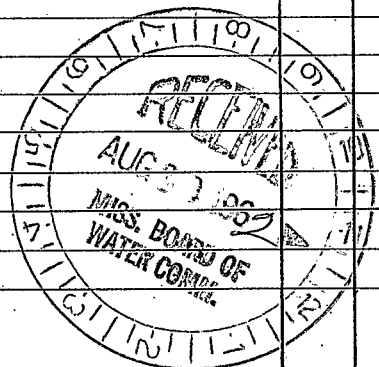

(Use Back Side)

Well No.

100

101

102

200