

MISSISSIPPI BOARD OF WATER COMMISSIONERS

RANKIN  
H 15  
1-15-64

WATER WELL DRILLERS LOG

Rankin  
**CODED**

Date: 1/15, 1964, Drilled by Forest Drilling Ser. Co. (Name)  
GARVER


(1) Owner of Land: James L. Gerwin  
(Name)  
Rt 1 - Brandon, Miss.  
(Address)  
3164  
(2) Location: 1/4, 1/4, Sec. T R,  
5 miles North, of Rankin  
(distance) (direction) (Nearest Town)  
(3) Topography:  (Hilly)  (Flat)  (Level)  
(4) Purpose of Well: Home  
(Domestic Irrigation, Municipal, Industrial, Other)

Description & Color of Materials Sand, Clay, Red Clay, Shell, etc.	Thick- ness Feet	Depth Feet
<u>Chalky Clay</u>	<u>0</u>	<u>28</u>
<u>Blue clay</u>		<u>266</u>
<u>Blue shale</u>		<u>327</u>
<u>B shale + 1th rock</u>		<u>456</u>
<u>fine shale sand + shale</u>		<u>533</u>
<u>shale + clay</u>		<u>576</u>
<u>shale</u>		<u>686</u>
<u>shale + 1th sand (silt)</u>		<u>696</u>
<u>shale + 1th silt</u>		<u>736</u>
<u>fine sand + 1th shale</u>		<u>777</u>
<u>fine sand</u>		<u>799</u>
<u>shale</u>		<u>812</u>

Information upon completion of well:

(1) Diameter 2 inches.  
(2) Total Depth 799 feet.  
(3) Water Level 177 feet below top of ground.  
(4) Cased to 777, Size 2"  
(5) Screen: Size 2", Length 18  
(6) Were any formations sealed against pollution?  
no yes,  no.

**CODED**

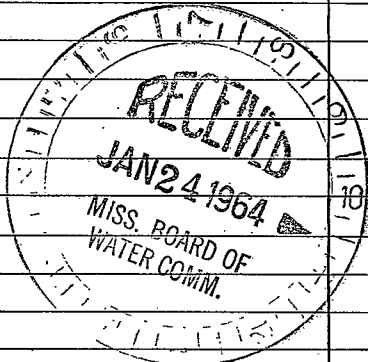

If YES depth of formation \_\_\_\_\_  
Why \_\_\_\_\_  
Drillers Remarks: \_\_\_\_\_

Well No.

(Use Back Side)

