

RANKIN MISSISSIPPI BOARD OF WATER COMMISSIONERS

~~D#~~ H 16

CODED

WATER WELL DRILLERS LOG

9-14-65

Date: 9-14, 1965, Driller: First Drilling County Rankin
 (Name)

(1) Owner of Land: J. G. Lawrence
 (Name)
RT 1 Box 206 Brandon,
 (Address) Miss

(2) Location: 1/4, 1/4, Sec. 31 T. 6 R. 4
15 miles N. East of Brandon
 (distance) (direction) (Nearest Town)

(3) Topography: _____
 (Hilly) (Flat) (Level)

(4) Purpose of Well: Home
 (Domestic Irrigation
 Municipal, Industrial, Other)

Description & Color of Materials Sand, Clay, Red Clay, Shell, etc.	Thick- ness Feet	Depth Feet
<u>Clay</u>		<u>26</u>
<u>Blue Clay</u>		<u>112</u>
<u>Clay + shells (lime)</u>		<u>152</u>
<u>Clay</u>		<u>202</u>
<u>Clay + shells (rock)</u>		<u>212</u>
<u>Harder Shell</u>		<u>232</u>
<u>Clay + shells</u>		<u>242</u>
<u>Shale</u>		<u>302</u>
<u>Soft shale + shells</u>		<u>342</u>
<u>Shale</u>		<u>352</u>
<u>Soft shale</u>		<u>392</u>
<u>Shale</u>		<u>488</u>
<u>7 sand + clay</u>		<u>502</u>

Information upon completion of well:

(1) Diameter 2 inches.

(2) Total Depth 502 feet.

(3) Water Level 152 feet below top of ground.

(4) Cased to 487, Size 2"

(5) Screen: Size 2", Length 157'

(6) Were any formations sealed against pollution?
 _____ yes, ✓ no.


If YES depth of formation _____

Why _____

Drillers Remarks: _____

CODED

CODED

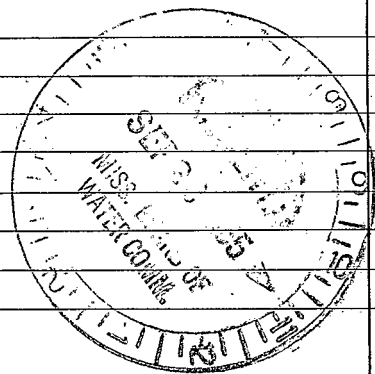

(Use Back Side)

Well No.

100

100

100