

RANKIN MISSISSIPPI BOARD OF WATER COMMISSIONERS

~~DH~~ H 18

**CODED**

5-31-66

WATER WELL DRILLERS LOG

Date: 5/31, 1966, Driller: Forest Drilling County Rankin  
(Name)

(1) Owner of Land:	Description & Color of Materials Sand, Clay, Red Clay, Shell, etc.	Thick- ness Feet	Depth Feet
<u>Clark Massey</u> (Name) <u>Rehatchie, Miss</u> (Address)	<u>yellow clay</u>		<u>20</u>
(2) Location: <u>1/4</u> , <u>1/4</u> , Sec <u>2</u> T <u>6R4</u>	<u>blue clay</u>		<u>217</u>
<u>10</u> miles <u>N.W.</u> of <u>Rehatchie</u> (distance) (direction) (Nearest Town)	<u>fine shell + clay</u>		<u>256</u>
(3) Topography: <input checked="" type="checkbox"/> (Hilly) <input type="checkbox"/> (Flat) <input type="checkbox"/> (Level)	<u>shaly shale</u>		<u>307</u>
(4) Purpose of Well: <u>Home</u> (Domestic Irrigation Municipal, Industrial, Other)	<u>fine sand + shaly shale</u>		<u>338</u>
	<u>shale</u>		<u>496</u>
	<u>shale + shaly silt</u>		<u>440</u>
	<u>shaly + shaly sand</u>		<u>430</u>
	<u>shaly + silt</u>		<u>466</u>
	<u>fine sand + shaly shale</u>		<u>476</u>
	<u>fine sand</u>		<u>492</u>
	<u>shale</u>		<u>519</u>
	<u>fine sand</u>		

Information upon completion of well:

(1) Diameter 7 inches.

(2) Total Depth 519 feet.


(3) Water Level 113 feet below top of ground.

(4) Cased to 504, Size 2"

(5) Screen: Size 2", Length 15ft

(6) Were any formations sealed against pollution?  
no

**CODED**

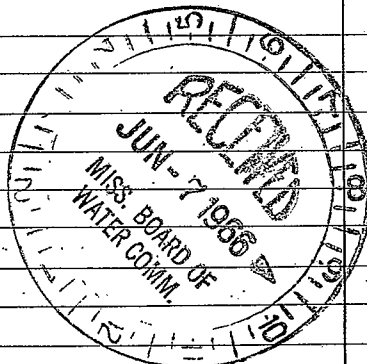

If YES depth of formation \_\_\_\_\_

Why \_\_\_\_\_

Drillers Remarks: \_\_\_\_\_

(Use Back Side)

Well No.

