

RANKIN
H 19
9-15-73

MISSISSIPPI
 BOARD OF WATER COMMISSIONERS **CODED**
 416 North State Street
 Jackson, Mississippi 39201

WATER WELL DRILLERS LOG

1973 John a Davis firm name Rankin county well located

date well completed
Sept 15 1973

LANDOWNER: J. W. MYRES
Fanning Miss.
 (mailing address)

WELL LOCATION:
 sec. 15 T. 6 N. R. 4 E.
0.6 miles East of Fanning
 (distance) (direction) (nearest town)

WELL PURPOSE: HOME
 (home, irrigation, municipal, industrial)

WELL COMPLETION DATA:

- (1) diameter (inches) 2"
- (2) total depth (feet) 480'
- (3) static water level (feet) 105' below above top of ground.
- (4) casing P.V.C. (material) (depth)
- 8 slot (size) if telescope see back.
- (5) screen 20' (length) 460' (depth to top)
- 8 slot (size) P.V.C. (material)
- (6) pump air comp. (HP) 2 H.P. (yield gpm) 18
- elect (type power)
- (7) electric log _____ (yes or no)
- _____ (organization running log)
- (8) how well bottom plugged pen.


description of formations encountered	from	to
<u>light clay</u>	<u>0</u>	<u>60</u>
<u>Blud clay</u>	<u>60</u>	<u>175</u>
<u>mucl.</u>	<u>175</u>	<u>190</u>
<u>Blud.</u>	<u>190</u>	<u>275</u>
<u>Sand</u>	<u>275</u>	<u>380</u>
<u>Fine Straps</u>		
<u>Clay</u>	<u>380</u>	<u>420</u>
<u>Sand</u>	<u>420</u>	<u>480</u>
<u>CODED</u>		

DRILLERS REMARKS:

OCT 15 1973

If well telescopes please sketch and show depths.

GROUND LEVEL

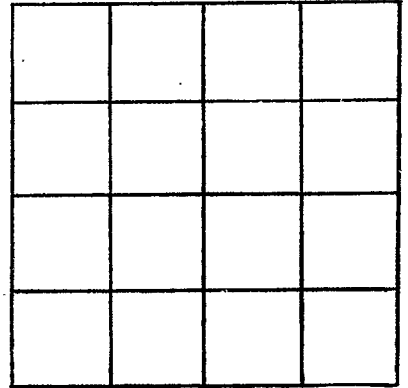

SECTION _____

Please indicate well location X.

ADDITIONAL INFORMATION

If more than one screen,
show locations of each on sketch.