

RANKIN

H2O

7-15-74

MISSISSIPPI  
 BOARD OF WATER COMMISSIONERS  
 416 North State Street  
 Jackson, Mississippi 39201

CODED

WATER WELL DRILLERS LOG

7-15

19

74

W. G. Butler

Rankin

date well completed

firm name

county well located

LANDOWNER:

Jim Buck Ross  
 Box 128  
 Pelahatchie, Miss.  
 (mailing address)

description of formations encountered

from

to

Clay + Sand

0 20

Clay

20- 387

Clay + Rock

283 384

Clay

307 325

Rock + clay

325 345

Rock, Shells Sand

345 365

Clay

365 385

Clay, Lignite Sand

385 405

Sand + clay

405 445

Sand

445 465

Clay

465 475

CODED

WELL LOCATION:

sec. 35 T. 6 N R. 4 E  
 S W  
 3 miles West of Pelahatchie  
 (distance) (direction) (nearest town)

WELL PURPOSE:

Home (home, irrigation, municipal, industrial)

WELL COMPLETION DATA:

- (1) diameter (inches) 2"
- (2) total depth (feet) 475
- (3) static water level (feet) 162 below above top of ground.
- (4) casing galv., 465,  
 (material) (depth)  
2" If telescope see back.  
 (size)
- (5) screen 10', 465  
 (length) (depth to top)  
2", SS-  
 (size) (material)
- (6) pump Qu Comp., 30  
 (HP) (yield gpm)  
Electric  
 (type power)
- (7) electric log \_\_\_\_\_  
 (yes or no)  
 \_\_\_\_\_  
 (organization running log)
- (8) how well bottom plugged 2" B.W.V


DRILLERS REMARKS:

RECEIVED  
 JUL 20 1974

MISS. BD. OF WATER COMMISSIONERS

If well telescopes please sketch and show depths.

GROUND LEVEL

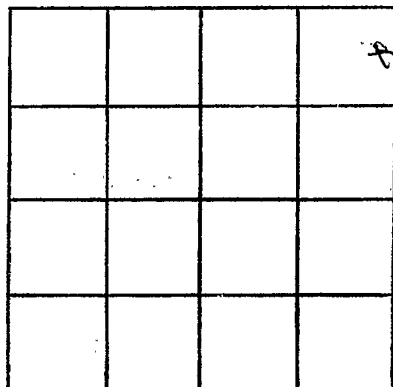

SECTION 35

Please indicate well location X.

ADDITIONAL INFORMATION

If more than one screen,  
show locations of each on sketch.