

RANKIN

H 21

7-27-74

MISSISSIPPI
 BOARD OF WATER COMMISSIONERS
 416 North State Street
 Jackson, Mississippi 39201

CODED

WATER WELL DRILLERS LOG

July 27 1974 John A. Davis Rankin
 date well completed firm name county well located

LANDOWNER: Brewman
 (mailing address)

description of formations encountered	from	to
Red clay	0	50
Blue	50	150
Sand streaks	150	250
Sand Fin.	250	300
Blue	300	340
Sand streaks	340	360
sand Good	360	410

WELL LOCATION:
 sec. 4 T. 6N R. 5E
0.4 miles East of Janner
 (distance) (direction) (nearest town)

WELL PURPOSE:
 (home, irrigation, municipal, industrial)

WELL COMPLETION DATA:

- (1) diameter (inches) 2"
- (2) total depth (feet) 410
- (3) static water level (feet) 190 below above top of ground.
- (4) casing PVC 380
 (material) (depth)
 (size) If telescope see back.
- (5) screen PVC
 (length) (depth to top)
8
 (size) (material)
- (6) pump 3
 (HP) (yield gpm)
Elect.
 (type power)
- (7) electric log no
 (yes or no)

(organization running log)

(8) how well bottom plugged pin


DRILLERS REMARKS:

CODED

RECEIVED
 AUG 12 1974
 MISS. BD. OF WATER COMMISSIONERS

If well telescopes please sketch and show depths.

GROUND LEVEL

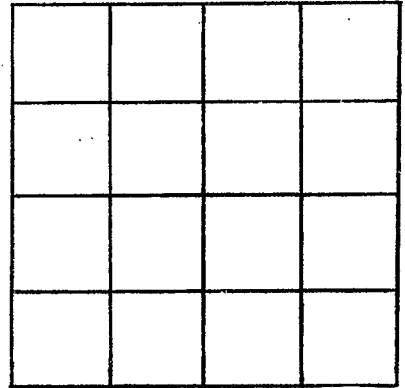

SECTION _____

Please indicate well location X.

ADDITIONAL INFORMATION

If more than one screen,
show locations of each on sketch.