

RANKIN

Rankin
H 24
3/18/83

MISSISSIPPI
 BOARD OF WATER COMMISSIONERS
 416 North State Street
 Jackson, Mississippi 39201

WATER WELL DRILLERS LOG

MARCH 18 1983 E.M. "Bud" CRESSWELL RANKIN
 date well completed firm name county well located

LANDOWNER:
 INTERNATIONAL Paper Co.
 BRANDON, MS.
 (mailing address)

description of formations encountered	from	to
SANDY CLAY	0	45
CLAY	45	420
SANDY SHALE	420	630
SAND	630	740

WELL LOCATION:
 sec. 31 T. 6 N R. 4 E
 3 miles NE of BRANDON
 (distance) (direction) (nearest town)

WELL PURPOSE: INDUSTRIAL
 (home, irrigation, municipal, industrial)

WELL COMPLETION DATA:

(1) diameter (inches) 4

(2) total depth (feet) 740

(3) static water level (feet) 165 below top of ground.

(4) casing PVC 700
 (material) (depth)
 4 (size) if telescope see back.

(5) screen 40 700
 (length) (depth to top)
 4 PVC (size) (material)

(6) pump 5 50
 (HP) (yield gpm).

(7) electric log No
 (yes or no)

(8) how well bottom plugged SAND SHARK

CODED


DEPT. OF NATURAL RESOURCES
 BUREAU OF LAND & WATER RESOURCES

APR 11 1983
 RECEIVED

DRILLERS REMARKS:

If well telescopes please sketch and show depths.

GROUND LEVEL

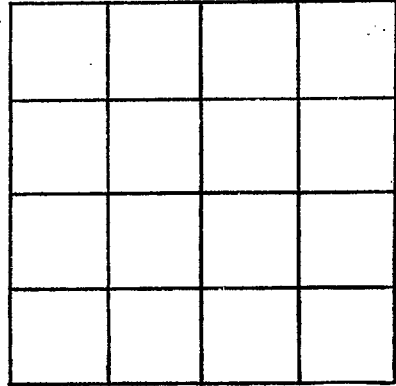

SECTION _____

Please indicate well location X.

ADDITIONAL INFORMATION

If more than one screen, show locations of each on sketch.