

MISSISSIPPI DEPARTMENT OF NATURAL RESOURCES

Bureau of Land and Water Resources

Southport Mall

P.O. Box 10631

Jackson, Mississippi 39209

WATER WELL DRILLERS LOG

RANKIN
H 25
3/8/83

3-8-83 *James Drilling Service, Inc.* Rankin
date well completed firm name county well located

LANDOWNER:	description of fomations encountered	from	to
<i>Shell Oil Company</i>			
<i>P.O. Box 61555</i>	<i>clay, streaked</i>	<i>0</i>	<i>473</i>
<i>New Orleans 70160</i>	<i>sand</i>		
(mailing address)			
WELL LOCATION: <i>1500 S + 1894 W of</i>	<i>rock, sand</i>	<i>473</i>	<i>525</i>
<i>No. 7 sec 2 T 6 R 4 N Yellow</i>	<i>chalk</i>	<i>525</i>	<i>546</i>
<i>Hauberg et al</i>			
(distance) (direction) (nearest town)			
WELL PURPOSE: <i>private supply</i>			
(home, irrigation, municipal, industrial)			
WELL COMPLETION DATA:			
(1) diameter (inches) <i>4"</i>			
(2) total depth (feet) <i>546</i>			
(3) static water level (feet) <i>140' below</i>			
top of ground.			
(4) casing <i>steel, 525'</i>			
(material) (depth)			
<i>3"</i>			
(size) If telescope see back.			
(5) screen <i>63' 462'</i>			
(length) (depth to top)			
<i>3" perforated</i>			
(size) (material)			
(6) pump <i>75</i>			
(HP) (yield gpm)			
<i>AC</i>			
(type power)			
(7) electric log <i>—</i>			
(yes or no)			
(organization running log)			
(8) how well bottom plugged <i>orange</i>			
<i>peel</i>			
DRILLERS REMARKS:			

CODED


DEPT. OF NATURAL RESOURCES
BUREAU OF LAND & WATER RESOURCES

APR 20 1983

RECEIVED

If well telescopes please sketch and show depths.

GROUND LEVEL

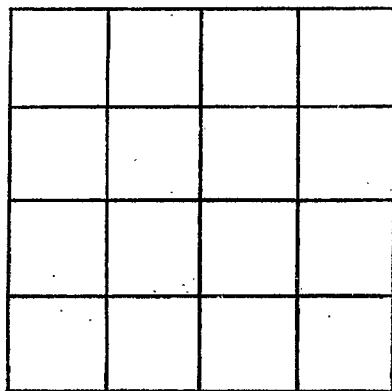

SECTION _____

Please indicate well location X.

ADDITIONAL INFORMATION

If more than one screen,
show locations of each on sketch.