

Rankin
 79
 12/62

MISSISSIPPI BOARD OF WATER COMMISSIONERS

WATER WELL DRILLERS LOG

J2
 MG
 CODED

Date: Dec. 5, 1962, Driller: Layne-Central Co. County Rankin
 (Name)

(1) Owner of Land: Town of Pelahatchie
 (Name)
Pelahatchie, Mississippi
 (Address)

(2) Location: 1/4, 1/4, Sec. 33 T6 R5
 miles of
 (distance) (direction) (Nearest Town)

(3) Topography:
 (Hilly) (Flat) (Level)

(4) Purpose of Well: Municipal
 (Domestic Irrigation
 Municipal, Industrial, Other)

Description & Color of Materials Sand, Clay, Red Clay, Shell, etc.	Thick- ness Feet	Depth Feet
red sandy clay	17	17
loose white sand	8	25
hard blue clay	270	295
sandy shale	10	305
hard shale	47	352
sandy shale	168	520
fine sand, h. p.	75	595
shale & sand strks	20	615
hard shale	76	691
rock	1	692
hard shale	3	695
hard rock	1	696
hard shale	4	700
hard rock	1	701
hard shale	4	705
hard rock	2	707
hard shale	10	717
hard rock	3	720
hard shale	20	740
hard rock	2	742
hard shale	12	754
sandy shale	39	793
sand & shale strks	20	813
hard shale	11	824
sand	17	841
hard shale	47	888
shale & sand strks	27	915
hard shale	33	948
h. p. sand	57	1005
hard shale	2	1007

Information upon completion of well:

(1) Diameter 10" inches.

(2) Total Depth 1005 feet.


(3) Water Level 137' feet below top of ground.

(4) Cased to 947', Size 10"

(5) Screen: Size 6", Length 50'

(6) Were any formations sealed against pollution?
 yes, no.

If YES depth of formation
 Why Required
 Drillers Remarks:

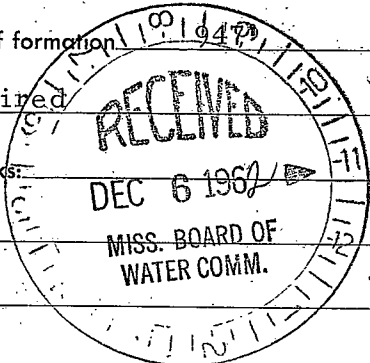

(Use Back Side)

Well No.

(X)