

CODED

MISSISSIPPI
 BOARD OF WATER COMMISSIONERS
 416 North State Street
 Jackson, Mississippi 39201

WATER WELL DRILLERS LOG

Rankin
J11
4-67

4-18 1967 Just Drilling Rankin
 date well completed firm name county well located

LANDOWNER: J. G. Smith

description of formations encountered

from to

Box 372

Brown Clay 0 25

Oloatchie Miss
 (mailing address)

Blue Clay 226

Clay + silt + limonite 266

Shale 289

WELL LOCATION:

sec. 17 T. 6 N. R. 5 E
3 miles North of Oloatchie
 (distance) (direction) (nearest town)

Shale + Rock 309

Sandy Shell 329

Soft Shale + Mdy Sand 391

Soft Shale + Silt + Sand 411

7 ft Sand + Soft Shale 440

Thin Sand 452

Thin Sand 484

Sand + Silt Clay 494

Thin Sand + Silt Cl 514

Dark Sand 563

WELL PURPOSE: Home
 (home, irrigation, municipal, industrial)

WELL COMPLETION DATA:

(1) diameter (inches) 2"

(2) total depth (feet) 561

(3) static water level (feet) 198 below above top of ground.

(4) casing Galv 546
 (material) (depth)

15 if telescope see back.
 (size)

(5) screen 15 ft, 546
 (length) (depth to top)

2", 4 in dia
 (size) (material)

(6) pump 5 HP 1200 br. hr.
 (HP) (yield gpm)

Electric
 (type power)


(7) electric log no
 (yes or no)

(organization running log)

(8) how well bottom plugged Backwash
value


DRILLERS REMARKS:

CODED

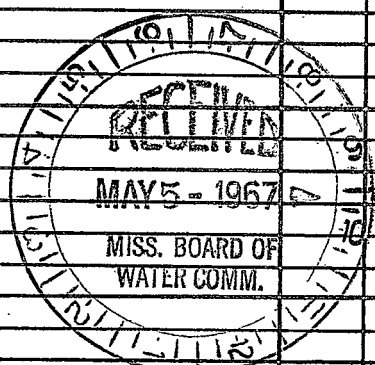

If well telescopes please sketch and show depths.

GROUND LEVEL

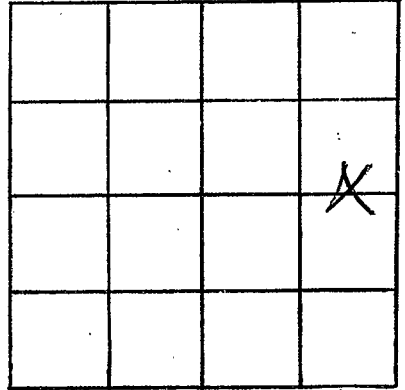

SECTION 17

Please indicate well location X.

ADDITIONAL INFORMATION

If more than one screen, show locations of each on sketch.