

# CODED

MISSISSIPPI  
 BOARD OF WATER COMMISSIONERS  
 416 North State Street  
 Jackson, Mississippi 39201

## WATER WELL DRILLERS LOG

Rankin  
J 12  
9-67

9-18 1967 Ferret Drilling Rankin  
 date well completed firm name county well located

LANDOWNER: John Edwards  
Palahatchie,  
Miss  
 (mailing address)

WELL LOCATION:  
 sec. 8 T. 6 N. R. 5 E  
5 miles North of Palahatchie  
 (distance) (direction) (nearest town)


WELL PURPOSE: Chicken Farm  
 (home, irrigation, municipal, industrial)

### WELL COMPLETION DATA:

- (1) diameter (inches) 2"
- (2) total depth (feet) 561
- (3) static water level (feet) 150 below top of ground.
- (4) casing Galv 546  
 (material) (depth)  
2"  
 (size) if telescope see back.
- (5) screen 15 ft, 546  
 (length) (depth to top)  
2", 4m Broad  
 (size) (material)
- (6) pump 3 1100 GPH  
 (HP) (yield gpm)  
Elect  
 (type power)
- (7) electric log No  
 (yes or no)  
 (organization running log)
- (8) how well bottom plugged bedrock  
value

description of formations encountered	from	to
<u>Brown Clay</u>	<u>0</u>	<u>23</u>
<u>Blue Clay</u>		<u>202</u>
<u>Shale + 5th sand rock</u>		<u>222</u>
<u>Shale</u>		<u>262</u>
<u>Shale + Rock</u>		<u>294</u>
<u>Shale</u>		<u>302</u>
<u>Fine Sand + 5th rock</u>		<u>302</u>
<u>Shale + 5th F. Sand</u>		<u>382</u>
<u>Shale</u>		<u>442</u>
<u>Shale + 5th F. Sand</u>		<u>462</u>
<u>Shale</u>		<u>480</u>
<u>Fine Sand</u>		<u>496</u>
<u>Shale</u>		<u>502</u>
<u>Fine Sand</u>		<u>50</u>
<u>Fine Sand</u>		<u>561</u>


# CODED

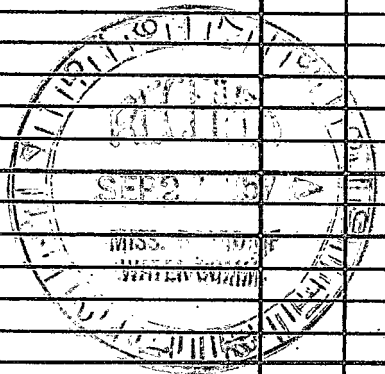

DRILLERS REMARKS:

If well telescopes please sketch and show depths.

GROUND LEVEL

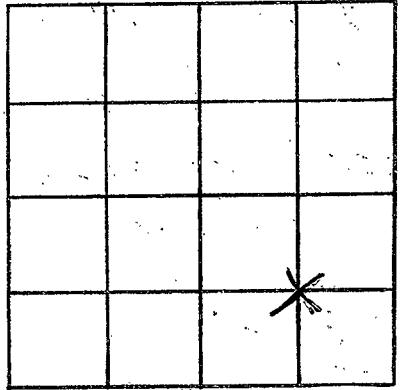

SECTION 8

Please indicate well location X.

ADDITIONAL INFORMATION

If more than one screen, show locations of each on sketch.