

**CODED**

MISSISSIPPI  
BOARD OF WATER COMMISSIONERS  
416 North State Street  
Jackson, Mississippi 39201

MES  
53

**WATER WELL DRILLERS LOG**

Rankin
913
5-68

53 1968 Janet Drilling Co Rankin  
 date well completed firm name county well located

LANDOWNER: Rankin City Board of Supervisors  
 Pelahatchie, Miss  
 (mailing address)

description of formations encountered	from	to
Clay	0	5
Red Sand		36
Blue Clay		204
Shale		234
Shale + Sths Rock		265
Hardy Shell + Sths "		287
Hardy Shell + Clay		307
Shale + Sths 7' Sand		348
Shale + Sths Sand		368
Thin Sand		373
Clay + Sths 7' Sand		389
7' Sand + Sths Clay		409
Thin Sand		448


WELL LOCATION: Pelahatchie Lake  
 sec 29 T 6 N R 5 E E  
 S W  
 2 miles N/W of Pelahatchie  
 (distance) (direction) (nearest town)

WELL PURPOSE: Lake  
 (home, irrigation, municipal, industrial)

**WELL COMPLETION DATA:**

- (1) diameter (inches) 2"
- (2) total depth (feet) 448
- (3) static water level (feet) 145 below top of ground.
- (4) casing Galv 433 (material) (depth)
- 2" if telescope see back. (size)
- (5) screen 15ft 433 (length) (depth to top)
- 2" Brass 1/2" (size) (material)
- (6) pump (HP) (yield gpm)
- (type power)
- (7) electric log No (yes or no)
- (organization running log)
- (8) how well bottom plugged packed w/ gravel


**CODED**

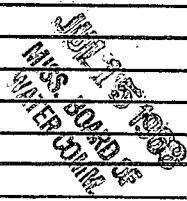

DRILLERS REMARKS:

If well telescopes please sketch and show depths.

GROUND LEVEL

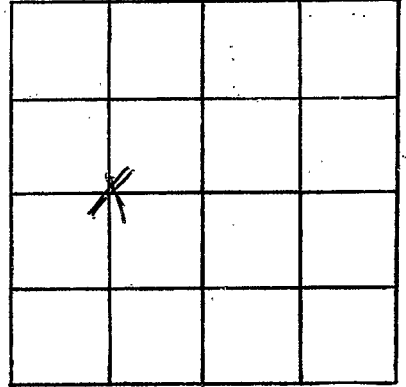

SECTION 29

Please indicate well location X.

ADDITIONAL INFORMATION

If more than one screen, show locations of each on sketch.