

**CODED**

MISSISSIPPI  
BOARD OF WATER COMMISSIONERS  
416 North State Street  
Jackson, Mississippi 39201

WATER WELL DRILLERS LOG

Rankin  
814  
5-68

5-17 1968 First Drilling Co Rankin  
date well completed firm name county well located

LANDOWNER: Fred Davis  
Delahatchie  
Miss  
(mailing address)

WELL LOCATION:  
sec. 7 T. 6 N. R. 5E  
S. E.  
5 miles North of Delahatchie  
(distance) (direction) (nearest town)

WELL PURPOSE: Chicken Farm  
(home, irrigation, municipal, industrial)

WELL COMPLETION DATA:

- (1) diameter (inches) 2"
- (2) total depth (feet) 537
- (3) static water level (feet) 164 below top of ground.
- (4) casing Galv, 537,  
(material) (depth)  
2"  
(size) If telescope see back.
- (5) screen 15 ft, 537  
(length) (depth to top)  
2", Stainless Steel  
(size) (material)
- (6) pump 3, 1000 GPH  
(HP) (yield gpm)  
Elect  
(type power)
- (7) electric log No  
(yes or no)  
  
(organization running log)
- (8) how well bottom-plugged Backwash Valve

description of formations encountered	from	to
Brown Clay	0	34
Blue Clay		184
Clay + Shale Sand Rock		204
Clay		226
Light Sand		270
Hard Shell		286
Hard Shell + Clay		307
Clay + Fine Sand		317
Clay		389
Clay + Shale Sand		443
Fine Sand		450
Fine Sand		466
Clay + Medium Sand		471
Med Sand + Clay		488
Fine Sand + Clay		520
Soft Clay + Med Sand		530
Hard Sand		533


**CODED**

APR 15 1968  
MISS. BOARD OF  
WATER COMMISSIONERS

DRILLERS REMARKS:

If well telescopes please sketch and show depths.

GROUND LEVEL

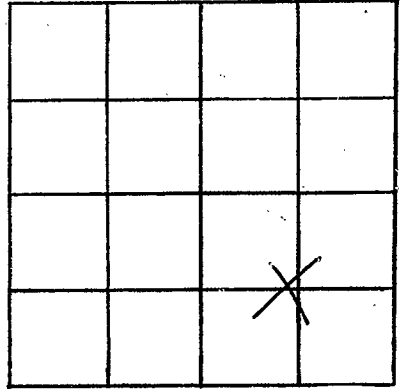

SECTION 7

Please indicate well location X.

ADDITIONAL INFORMATION

If more than one screen,  
show locations of each on sketch.