

N

RANKIN

4-25-63 J.15

WATER WELL DRILLERS LOG

CODED

Date: 4/25, 1963, Driller: Frank W. Kelly, Sr. County Franklin
(Name)

(1) Owner of Land: L.E. Harpe
(Name)
Delehatchie, Miss
(Address)

(2) Location: 1/4, 1/4, Sec 33 T6 R5,
miles South, of Delehatchie
(distance) (direction) (Nearest Town)

(3) Topography: _____
(Hilly) (Flat) (Level)

(4) Purpose of Well: _____
(Domestic Irrigation
Municipal, Industrial, Other)

Description & Color of Materials Sand, Clay, Red Clay, Shell, etc.	Thick- ness Feet	Depth Feet
<u>Chalky Clay</u>	<u>0</u>	<u>25</u>
<u>Blue clay + sh + silt</u>	<u>0</u>	<u>70</u>
<u>Blue Clay</u>	<u>0</u>	<u>266</u>
<u>Blue shale</u>	<u>0</u>	<u>430</u>
<u>Fine shale + shell</u>	<u>0</u>	<u>450</u>
<u>Shale</u>	<u>0</u>	<u>524</u>
<u>Shale + sh + sand</u>	<u>0</u>	<u>534</u>
<u>Fine sand</u>	<u>0</u>	<u>555</u>

Information upon completion of well:

(1) Diameter 2" inches.

(2) Total Depth 555 feet.

(3) Water Level 170 feet below top of ground.

(4) Cased to 540, Size 2"

(5) Screen: Size 2", Length 15


(6) Were any formations sealed against pollution?
_____ yes, X no.

If YES depth of formation _____

Why _____

Drillers Remarks: _____

CODED

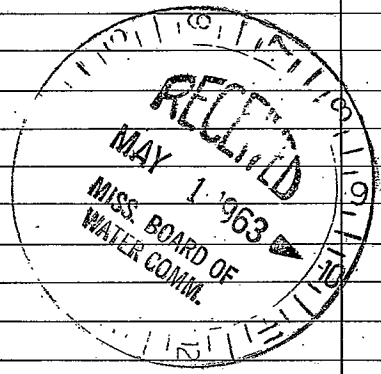

(Use Back Side)

Well No.

