

RANKIN MISSISSIPPI BOARD OF WATER COMMISSIONERS

~~E-25~~ J 16
5-20-66

WATER WELL DRILLERS LOG

CODED

Date: 5/20, 1966, Driller: Forest Dullin County Rankin
(Name)

(1) Owner of Land: M. H. McKay
(Name)
Delatchie, Texas
(Address)

(2) Location: 1/4, 1/4, Sec. 6, T6R5
9 miles North of Delatchie
(distance) (direction) (Nearest Town)
Highway 43

(3) Topography: _____
(Hilly) (Flat) (Level)

(4) Purpose of Well: Home
(Domestic Irrigation
Municipal, Industrial, Other)

Description & Color of Materials Sand, Clay, Red Clay, Shell, etc.	Thick- ness Feet	Depth Feet
Brown Clay		12
br. Clay + Sand		22
Brown Clay		30
Blue Clay		42
Lime Rock		45
Rock + Clay		52
Clay + Sh. Rock		72
Clay		110
Rock		114
Clay + Sandy Shell		122
Sandy Shell		142
musky sand		152
Clay		172
Clay + Gyps. Sand		177
fine sand		177
fair sand		187
good sand		197
fair sand		207
good sand		217
good sand		400

Information upon completion of well:

(1) Diameter 2 inches.

(2) Total Depth 400 feet.

(3) Water Level 126 feet below top of ground.

(4) Cased to 390, Size 2"


(5) Screen: Size 2", Length 10ft.

(6) Were any formations sealed against pollution?
_____ yes, ✓ no.

If YES depth of formation _____

Why _____

Drillers Remarks: _____

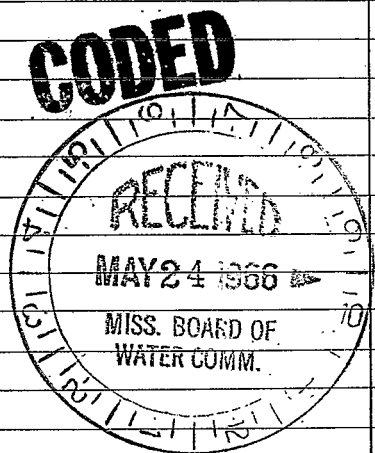

Well No.

(Use Back Side)

000000