

RANKIN

J17
3-26-63

WATER WELL DRILLERS LOG

CODED
in

Date: 3/26, 1963, Driller: Forest Delg. Dev. County: Scott
(Name)

(1) Owner of Land: J. L. Edwards
(Name)
Brandon, Miss.
(Address)

(2) Location: 1/4, 1/4, Sec 8 T6 R5
5 miles North of Delehatie
(distance) (direction) (Nearest Town)

(3) Topography: _____
(Hilly) (Flat) (Level)

(4) Purpose of Well: Home
(Domestic Irrigation
Municipal, Industrial, Other)

Description & Color of Materials Sand, Clay, Red Clay, Shell, etc.	Thick- ness Feet	Depth Feet
Brown Clay		27
Blue Clay		152
Gravel		177
Shale		247
Shale + Rock		257
Clay + Sandy Shell		267
Sandy Shell		287
Fine Sand + Clay		297
mpy Sand		307
Clay + Slt's sand		317
Clay		357
sh clay + fine sand		417
mpy sand		423
Rock		427
Fine Sand		433
Fine Sand + Shale		448
Fine Sand		469
sh Shale		474
mpy Sand		483
mpy Sand + Shale		503
Fine Sand		553

Information upon completion of well:

(1) Diameter 2" inches.

(2) Total Depth 533 feet.

(3) Water Level 150 feet below top of ground.

(4) Cased to 518, Size 2"

(5) Screen: Size 2", Length 15


(6) Were any formations sealed against pollution?
 yes, no.

If YES depth of formation _____

Why _____

Drillers Remarks: _____

CODED

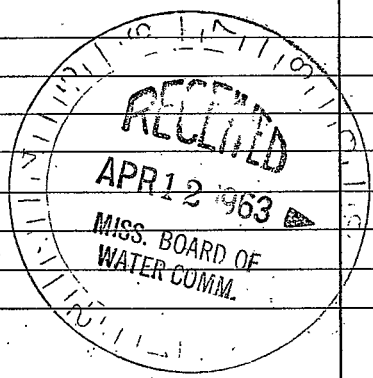

(Use Back Side)

Well No.

