

RANKIN  
J 18  
7-23-75

MISSISSIPPI  
 BOARD OF WATER COMMISSIONERS  
 416 North State Street  
 Jackson, Mississippi 39201

WATER WELL DRILLERS LOG **CODED**

7/23 1975 Forest Drilling Rankin  
 date well completed firm name county well located


LANDOWNER:	description of formations encountered	from
<u>Henry Spall</u>	<u>yellow clay</u>	<u>0 25</u>
<u>Rt 2 Box 146 Maeston</u> (mailing address)	<u>Blue clay</u>	<u>25-309</u>
<b>WELL LOCATION:</b>	<u>Shale Rock + silt</u>	<u>309 330</u>
sec. <u>2</u> T. <u>6</u> N R. <u>5</u> E	<u>Silt Clay</u>	<u>330 430</u>
<u>4</u> miles <u>S</u> of <u>Forest</u>	<u>Fine Sand + bit. shale</u>	<u>430 534</u>
(distance) (direction) (nearest town)	<u>Fine sand</u>	<u>534 566</u>
	<u>Fine sand + lignite</u>	<u>566 566</u>

**WELL PURPOSE:** Home  
 (home, irrigation, municipal, industrial)

**WELL COMPLETION DATA:**

- (1) diameter (inches) 2
- (2) total depth (feet) 566
- (3) static water level (feet) 178 below top of ground.
- (4) casing Galv. 566  
(material) (depth)
- \_\_\_\_\_ If telescope see back.  
(size)
- (5) screen 10 556  
(length) (depth to top)
- 2 3/8" #.008  
(size) (material)
- (6) pump 5 \_\_\_\_\_  
(HP) (yield gpm)
- Electric  
(type power)
- (7) electric log no  
(yes or no)
- no  
(organization running log)
- (8) how well bottom plugged Bw. true

**CODED**

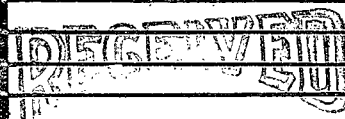

DRILLERS REMARKS:

FEB 27 1976

If well telescopes please sketch and show depths.

GROUND LEVEL

			X

SECTION 2

Please indicate well location X.

ADDITIONAL INFORMATION

If more than one screen, show locations of each on sketch.