

RANKIN

J 19

5-23-61

WATER WELL DRILLERS LOG

CODED Co?

Date: 5/23, 1961, Driller: Johnnie Beasley County Rankin
 (Name)

(1) Owner of Land: Ray Ivy
 (Name)
Pelahatchie, Miss. 11-6-5
 (Address)
 The best way to get to this well is to go past Pelahatchie on Hwy. 80 to R, Tip-toe end and turn left on old Hwy. 80 and follow it for about 2 miles and take your left on big country road
 (distance) (direction) (Nearest Town)
 (3) Topography: x
 (Hilly) (Flat) (Level)
 go about 6 miles and the well is on left
 (4) Purpose of Well: Domestic
 (Domestic Irrigation Municipal, Industrial, Other)

Description & Color of Materials Sand, Clay, Red Clay, Shell, etc.	Thick-ness Feet	Depth Feet
Brown clay.	0	30
Blue clay.	30	205
Shale & clay.	205	280
Rock & shale.	280	286
Shale & silt.	286	327
Fine sand & muck.	327	368
Sand. (Screen setting)	368	413


CODED

Information upon completion of well:

- (1) Diameter 2 inches.
- (2) Total Depth 413 feet.
- (3) Water Level 180' feet below top of ground.
- (4) Cased to 403', Size 2"
- (5) Screen: Size 2", Length 10'
- (6) Were any formations sealed against pollution?
no yes, x no.

If YES depth of formation _____
 Why _____

Drillers Remarks: Good well.

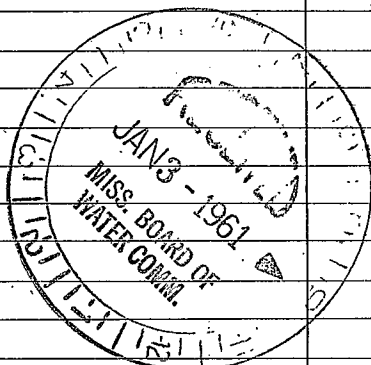

1957

10

1
2
3
4
5
6
7
8
9
10

1957