

RANKIN MISSISSIPPI BOARD OF WATER COMMISSIONERS

J 22

2-28-66

WATER WELL DRILLERS LOG

CODED

Date: 2/28, 1966, Driller: Forest Drilling County Rankin
(Name)

(1) Owner of Land: Cecil Payne
(Name)
Relatichie, Miss.
(Address)

(2) Location: 1/4, 1/4, Sec. 35 T 6 R 5,
4 miles East of Relatichie
(distance) (direction) (Nearest Town)

(3) Topography: (Level)
(Hilly) (Flat) (Level)

(4) Purpose of Well: Chicken
(Domestic Irrigation Municipal, Industrial, Other)

Description & Color of Materials Sand, Clay, Red Clay, Shell, etc.	Thick- ness Feet	Depth Feet
Brown Clay		12
Clay + Sh. Mgy Sand		32
Blue Clay		112
Clay + Sh. Mgy Sand		122
Blue Clay		182
Clay		240
Shale		370
Shale + Sh. Mgy Sand		400
Sandy Shell		430
Shale		440
Shale + Sh. Mgy Sand		470
Mucky Sand + Clay		510
Fine Sand + Clay		520
Fine Sand		530
Shale		540
Shale + Sh. Mgy Sand		572
Fine Sand		602
Shale		612
Fine Sand + Shale		642
Fine Sand		702
Fine Sand		721

Information upon completion of well:

(1) Diameter 2 inches.

(2) Total Depth 721 feet.

(3) Water Level 169 feet below top of ground.

(4) Cased to 7.05, Size 2"


(5) Screen: Size 2", Length 16ft

(6) Were any formations sealed against pollution?
 _____ yes, no.

If YES depth of formation _____

Why _____

Drillers Remarks: _____

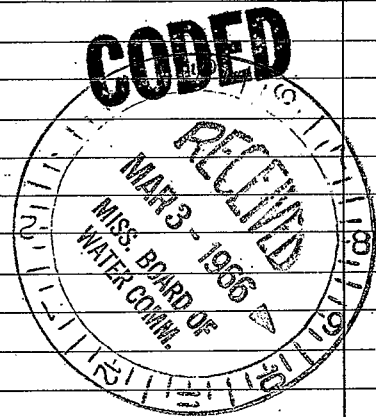

(Use Back Side)

Well No.

